

WATER WELL PLUGGING RECORD Form WWC-5P

KSA 82a-1212

ID NO.

MW-33D

1 LOCATION OF WATER WELL: Fraction NW ¼ SE ¼ SE ¼ SW ¼ Section Number 32 Township Number T 25 S Range Number 3 E W
 County: Butler


Street/Rural Address of Well Location; if unknown, distance & direction from nearest town or intersection: If at owner's address, check here Approximately one half mile east and south of NW Butler Road and SW Parallel Street, north of Benton, KS

Global Positioning Systems (GPS) information:
 Latitude: 37.82631 (in decimal degrees)
 Longitude: -97.12627 (in decimal degrees)
 Elevation: _____
 Horizontal Datum: WGS84, NAD83, NAD27
 Collection Method: _____

2 WATER WELL OWNER: El Paso Merchant Energy
 RR#, St. Address, Box #: 2 N. Nevada Ave.
 City, State ZIP Code: Colorado Springs, CO80903

GPS unit (Make/Model: Garmin etrek)
 Digital Map/Photo, Topographic Map, Land Survey
 Est. Accuracy: < 3 m, 3-5 m, 5-15 m, > 15 m

3 MARK WELL'S LOCATION WITH AN "X" IN SECTION BOX:

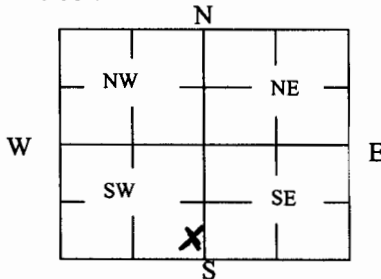

4 DEPTH OF WELL 31 ft.

WELL'S STATIC WATER LEVEL 12.38 ft

WELL WAS USED AS:

- Domestic
- Irrigation
- Feedlot
- Industrial
- Public Water Supply
- Oil Field Water Supply
- Domestic (Lawn & Garden)
- Air Conditioning
- Dewatering
- Monitoring
- Injection Well
- Other _____

Was a chemical/bacteriological sample submitted to Department? Yes No

5 TYPE OF BLANK CASING USED:

- Steel
- RMP (SR)
- Wrought
- Fiberglass
- Other (Specify below) _____
- PVC
- ABS
- Asbestos-Cement
- Concrete Tile

Blank casing diameter 4 in. Was casing pulled? Yes No If yes, how much all
 Casing height above or below land surface 30 in.

6 GROUT PLUG MATERIAL: Neat cement Cement grout Bentonite Other Top Soil

Grout Plug Intervals: From 0 ft. to 3 ft., From 3 ft. to 31 ft., From — ft. to — ft.

What is the nearest source of possible contamination:

- Septic tank
 - Sewer lines
 - Watertight sewer lines
 - Lateral lines
 - Cess pool
 - Seepage pit
 - Pit privy
 - Sewage lagoon
 - Feedyard
 - Livestock pens
 - Fuel storage
 - Fertilizer storage
 - Insecticide storage
 - Abandoned water well
 - Oil well/Gas well
 - Other (specify below) unknown
- Direction from well? unknown
 How many feet? unknown

FROM	TO	PLUGGING MATERIALS	FROM	TO	PLUGGING MATERIALS
0	3	Top Soil			
3	31	Bentonite			

7 CONTRACTOR'S OR LANDOWNER'S CERTIFICATION: This water well was plugged under my jurisdiction and was completed on (mo/day/year) 1-29-2019 and this record is true to the best of my knowledge and belief. Kansas Water Well Contractor's License No. 710. This Water Well Record was completed on (mo/day/year) 2-4-2019 under the business name of Below Ground Surface, Inc. by (signature) Craig K. [Signature]

Send one white copy to Kansas Department of Health & Environment, Geology Section, 1000 SW Jackson Street, Ste. 420, Topeka, KS 66612-1367. Send one copy to WATER WELL OWNER and retain one for your records.
 Visit us at <http://www.kdheks.gov/waterwell/index.html> Telephone 785-296-5524.