

1	LOCATION OF WATER WELL:	Fraction	Section Number	Township Number	Range Number
	County: <i>Butler</i>	<i>NW 1/4 SW 1/4 NE 1/4</i>	<i>35</i>	T <i>25</i> S	R <i>5</i> <i>EW</i>

Distance and direction from nearest town or city street address of well if located within city?

1400 North Main Street


2 WATER WELL OWNER: *Mark McCabe*

RR#, St. Address, Box # : 2849 West 4th
City, State, ZIP Code : El Dorado KS 67042

Board of Agriculture, Division of Water Resources
Application Number:

3 LOCATE WELL'S LOCATION WITH 4 DEPTH OF COMPLETED WELL 21 ft. ELEVATION: 1290.18

AN "X" IN SECTION BOX:

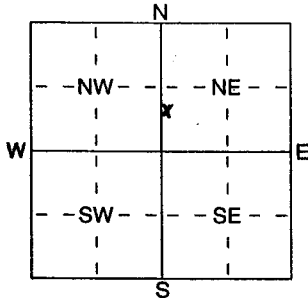

Depth(s) Groundwater Encountered 1 11.78 ft. 2 _____ ft. 3 _____ ft.

WELL'S STATIC WATER LEVEL 272.90 ft. below land surface measured on mo/day/yr 10/20/2003

Pump test data: Well water was ft. after hours pumping gpm

Est. Yield gpm: Well water was ft. after hours pumping gpm

WELL WATER TO BE USED AS: 5 Public water supply 8 Air conditioning 11 Injection well

1 Domestic 3 Feedlot 6 Oil field water supply 9 Dewatering 12 Other (Specify below)

2 Irrigation 4 Industrial 7 Domestic (lawn & garden) 10 Monitoring well MW-1

Was a chemical/bacteriological sample submitted to Department? Yes No X; If yes, mo/day/yr sample was submitted
Water Well Disinfected? Yes No X

5	TYPE OF BLANK CASING USED:
---	----------------------------

1 Steel
2 PVC
3 RMP (SR)
4 ABS

5 Wrought iron
6 Asbestos-Cement
7 Fiberglass

8 Concrete tile
9 Other (specify below)

CASING JOINTS: Glued Clamped
Welded
Threaded X

Blank casing diameter in. to ft., Dia in. to ft., Dia in. to ft.

Casing height above land surface flush in., weight 203 lbs./ft. Wall thickness or gauge No. Schedule 40

TYPE OF SCREEN OR PERFORATION MATERIAL:

1 Steel	3 Stainless Steel	5 Fiberglass	8 RMP (SR)	10 Acrylic (SR)
2 Brass	4 Galvanized Steel	6 Concrete tile	9 ABS	11 Other (Specify)
				12 None used (open hole)

SCREEN OR PERFORATION OPENINGS ARE:

1 Continuous slot 3 Mill slot 6 Wire wrapped 9 Drilled holes
2 Louvered shutter 4 Key punched 7 Torch cut 10 Other (specify) ft

SCREEN-PERFORATED INTERVALS: From 1.0 ft. to 20.5 ft., From _____ ft. to _____ ft.

From ft. to ft., From ft. to ft.

From 7.7 ft. to 21 ft., From _____ ft. to _____ ft.

6 GROUT MATERIAL: 1 Neat cement 2 Cement grout 3 Bentonite 4 Other

Grout Intervals: From 1.0 ft. to 2.2 ft. From _____ ft. to _____ ft. From _____ ft. to _____ ft.

What is the nearest source of possible contamination:

1 Septic tank	4 Lateral lines	7 Pit privy	11 Fuel storage	15 Oil well/Gas well
2 Sewer lines	5 Cess pool	8 Sewage lagoon	12 Fertilizer storage	16 Other (specify below)
3 Watertight sewer lines	6 Seepage pit	9 Feedyard	13 Insecticide storage

Direction from well? *northwest* How many feet? *30*

[illegible]

7] CONTRACTOR'S OR LANDOWNER'S CERTIFICATION: This water well was (1) constructed, (2) reconstructed, or (3) plugged under my jurisdiction and was completed on (mo/day/year) 10/08/2003 and this record is true to the best of my knowledge and belief. Kansas

Water Well Contractor's Licence No. 205 This Water Well Record was completed on (mo/day/yr) 11/02/2003
under the business name of 11-20-30x by (signature) [Signature]