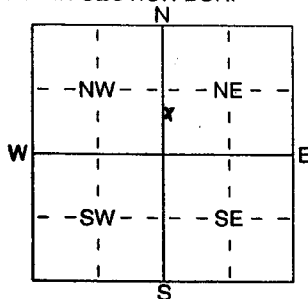


1 LOCATION OF WATER WELL:	Fraction	Section Number	Township Number	Range Number
County: <u>Butler</u>	<u>NW 1/4 SW 1/4 NE 1/4</u>	<u>35</u>	T <u>25</u> S	R <u>5</u> <u>EW</u>

Distance and direction from nearest town or city street address of well if located within city?

1400 North Main Street2 WATER WELL OWNER: Mark McCabeRR#, St. Address, Box # : 2849 West 4th
City, State, ZIP Code : El Dorado, KS 67042Board of Agriculture, Division of Water Resources
Application Number:3 LOCATE WELL'S LOCATION WITH 4 DEPTH OF COMPLETED WELL 20 ft. ELEVATION: 1298.84

AN "X" IN SECTION BOX:

Depth(s) Groundwater Encountered 1 13.11 ft. 2 ft. 3 ft.WELL'S STATIC WATER LEVEL 1277.28 ft. below land surface measured on mo/day/yr 10/20/2003

Pump test data: Well water was ft. after hours pumping gpm

Est. Yield gpm: Well water was ft. after hours pumping gpm

WELL WATER TO BE USED AS: 5 Public water supply 8 Air conditioning 11 Injection well

1 Domestic 3 Feedlot 6 Oil field water supply 9 Dewatering 12 Other (Specify below)

2 Irrigation 4 Industrial 7 Domestic (lawn & garden) 10 Monitoring well NW-3Was a chemical/bacteriological sample submitted to Department? Yes No X; If yes, mo/day/yr sample was submitted
Water Well Disinfected? Yes No

5 TYPE OF BLANK CASING USED: 5 Wrought Iron 8 Concrete tile CASING JOINTS: Glued Clamped

1 Steel 3 RMP (SR) 9 Other (specify below) Welded

2 PVC 4 ABS 7 Fiberglass Threaded XBlank casing diameter 2 in. to 10 ft. Dia in. to ft. Dia in. to ft.Casing height above land surface flush in., weight 203 lbs./ft. Wall thickness or gauge No. schedule 40TYPE OF SCREEN OR PERFORATION MATERIAL: 7 PVC 10 Asbestos-Cement

1 Steel 3 Stainless Steel 8 RMP (SR) 11 Other (Specify)

2 Brass 4 Galvanized Steel 9 ABS 12 None used (open hole)

SCREEN OR PERFORATION OPENINGS ARE: 5 Guazed wrapped 8 Saw cut 11 None (open hole)

1 Continuous slot 3 Mill slot 9 Drilled holes

2 Louvered shutter 4 Key punched 10 Other (specify) ft.

SCREEN-PERFORATED INTERVALS: From 10 ft. to 20 ft. From ft. to ft.GRAVEL PACK INTERVALS: From 8.0 ft. to 20 ft. From ft. to ft.

From ft. to ft. From ft. to ft.

From ft. to ft. From ft. to ft.

From ft. to ft. From ft. to ft.

From ft. to ft. From ft. to ft.

From ft. to ft. From ft. to ft.

6 GROUT MATERIAL: 1 Neat cement 2 Cement grout 3 Bentonite 4 OtherGrout intervals: From 1.0 ft. to 8.0 ft. From ft. to ft. From ft. to ft.

What is the nearest source of possible contamination:

1 Septic tank 4 Lateral lines 7 Pit privy 10 Livestock pens 14 Abandoned water well

2 Sewer lines 5 Cess pool 8 Sewage lagoon 11 Fuel storage 15 Oil well/Gas well

3 Watertight sewer lines 6 Seepage pit 9 Feedyard 12 Fertilizer storage 16 Other (specify below)

Direction from well? north How many feet? 80

FROM TO LITHOLOGIC LOG FROM TO PLUGGING INTERVALS

0 4" Concrete 109 # 0035 83344" 15' Sand / Clay15' 20' Clay. Very dark brown, solid,moist7 CONTRACTOR'S OR LANDOWNER'S CERTIFICATION: This water well was (1) constructed, (2) reconstructed, or (3) plugged under my jurisdiction and was completed on (mo/day/year) 10/08/2003 and this record is true to the best of my knowledge and belief. KansasWater Well Contractor's Licence No 205 This Water Well Record was completed on (mo/day/yr) 10/08/2003under the business name of Handex by (signature) [Signature]