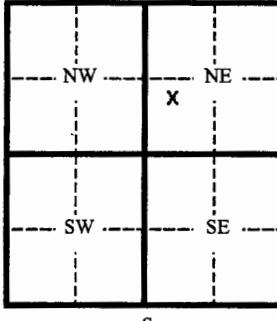



## WATER WELL PLUGGING RECORD

Form WWC-5P

KSA 82a-1212

ID No. 00358310

1 LOCATION OF WATER WELL:		Fraction County: Butler	Section Number NW 1/4 SW 1/4 NE 1/4	35	Township Number 25	Range Number 05E	
Distance and direction from nearest town or city street address of well if located within city? <b>1400 N Main Street</b>	
2 WATER WELL OWNER:		Mark McCabe 2849 West 4 <sup>th</sup> St. El Dorado, KS 67042		Board of Agriculture, Division of Water Resources Application Number:	
3 MARK WELL'S LOCATON WITH AN "X" IN SECTION BOX:		4 DEPTH OF WELL 20.51	ft. Originally drilled to 21 feet bgs	
		WELL'S STATIC WATER LEVEL 4.71		ft.	
WELL WAS USED AS:	
<table> <tbody> <tr><td>1 Domestic</td><td>5 Public Water Supply</td><td>9 Dewatering</td></tr> <tr><td>2 Irrigation</td><td>6 Oil Field Water Supply</td><td>10 Monitoring Well</td></tr> <tr><td>3 Feedlot</td><td>7 Lawn and Garden (domestic)</td><td>11 Injection Well</td></tr> <tr><td>4 Industrial</td><td>8 Air Conditioning</td><td>12 Other</td></tr> </tbody> </table>							1 Domestic	5 Public Water Supply	9 Dewatering	2 Irrigation	6 Oil Field Water Supply	10 Monitoring Well	3 Feedlot	7 Lawn and Garden (domestic)	11 Injection Well	4 Industrial	8 Air Conditioning	12 Other	
1 Domestic	5 Public Water Supply	9 Dewatering	
2 Irrigation	6 Oil Field Water Supply	10 Monitoring Well	
3 Feedlot	7 Lawn and Garden (domestic)	11 Injection Well	
4 Industrial	8 Air Conditioning	12 Other	
Was a chemical/bacteriological sample submitted to Department? Yes <input type="checkbox"/> No <input checked="" type="checkbox"/> X	
If yes, mo/day/yr sample was submitted	
Water Well Disinfected: Yes <input type="checkbox"/> No <input checked="" type="checkbox"/> X	
5 TYPE OF BLANK CASING USED:	
<table> <tbody> <tr><td>1 Steel</td><td>3 RMP (SR)</td><td>5 Wrought</td><td>7 Fiberglass</td><td>9 Other (specify below)</td></tr> <tr><td><input type="checkbox"/> 2 PVC</td><td><input type="checkbox"/> 4 ABC</td><td><input type="checkbox"/> 6 Asbestos-Cement</td><td><input type="checkbox"/> 8 Concrete Tile</td><td></td></tr> </tbody> </table>							1 Steel	3 RMP (SR)	5 Wrought	7 Fiberglass	9 Other (specify below)	<input type="checkbox"/> 2 PVC	<input type="checkbox"/> 4 ABC	<input type="checkbox"/> 6 Asbestos-Cement	<input type="checkbox"/> 8 Concrete Tile	
1 Steel	3 RMP (SR)	5 Wrought	7 Fiberglass	9 Other (specify below)	
<input type="checkbox"/> 2 PVC	<input type="checkbox"/> 4 ABC	<input type="checkbox"/> 6 Asbestos-Cement	<input type="checkbox"/> 8 Concrete Tile	
Blank casing diameter <b>2</b> in. Was casing pulled? Yes <input checked="" type="checkbox"/> No <input type="checkbox"/> If yes, how much <b>21 feet</b>	
Casing height above or below land surface <b>in. Overdrilled to 20 feet below ground surface</b>	
6 GROUT PLUG MATERIAL: 1 Neat cement 2 Cement grout 3 Bentonite 4 Other	
Grout Plug Intervals From <b>0.5</b> ft. to <b>20.51</b> ft. From _____ ft. to _____ ft. From _____ ft. to _____ ft.	
What is the nearest source of possible contamination:	
<table> <tbody> <tr><td>1 Septic tank</td><td>6 Seepage pit</td><td>11 Fuel storage</td><td>16 Other (specify below)</td></tr> <tr><td>2 Sewer lines</td><td>7 Pit privy</td><td>12 Fertilizer storage</td><td></td></tr> <tr><td>3 Watertight sewer lines</td><td>8 Sewage lagoon</td><td>13 Insecticide storage</td><td></td></tr> <tr><td>4 Lateral lines</td><td>9 Feedyard</td><td>14 Abandoned water well</td><td></td></tr> <tr><td>5 Cess Pool</td><td>10 Livestock pens</td><td>15 Oil well/ Gas well</td><td></td></tr> </tbody> </table>							1 Septic tank	6 Seepage pit	11 Fuel storage	16 Other (specify below)	2 Sewer lines	7 Pit privy	12 Fertilizer storage		3 Watertight sewer lines	8 Sewage lagoon	13 Insecticide storage		4 Lateral lines	9 Feedyard	14 Abandoned water well		5 Cess Pool	10 Livestock pens	15 Oil well/ Gas well	
1 Septic tank	6 Seepage pit	11 Fuel storage	16 Other (specify below)	
2 Sewer lines	7 Pit privy	12 Fertilizer storage	
3 Watertight sewer lines	8 Sewage lagoon	13 Insecticide storage	
4 Lateral lines	9 Feedyard	14 Abandoned water well	
5 Cess Pool	10 Livestock pens	15 Oil well/ Gas well	
Direction from well? _____ How many feet? _____	
<table border="1"> <thead> <tr> <th>FROM</th> <th>TO</th> <th>CODE</th> <th colspan="4">PLUGGING MATERIALS</th> </tr> </thead> <tbody> <tr><td>0</td><td>0.5</td><td></td><td colspan="4">Concrete</td></tr> <tr><td>0.5</td><td>20.51</td><td></td><td colspan="4">Bentonite</td></tr> <tr><td></td><td></td><td></td><td colspan="4"></td></tr> <tr><td></td><td></td><td></td><td colspan="4"></td></tr> <tr><td></td><td></td><td></td><td colspan="4"></td></tr> <tr><td></td><td></td><td></td><td colspan="4"></td></tr> <tr><td></td><td></td><td></td><td colspan="4"></td></tr> <tr><td></td><td></td><td></td><td colspan="4"></td></tr> </tbody> </table>							FROM	TO	CODE	PLUGGING MATERIALS				0	0.5		Concrete				0.5	20.51		Bentonite	
FROM	TO	CODE	PLUGGING MATERIALS	
0	0.5		Concrete	
0.5	20.51		Bentonite	

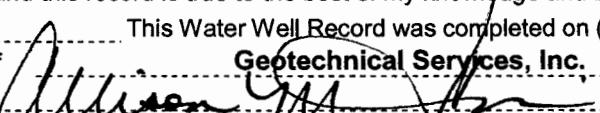7	CONTRACTOR'S OR LANDOWNER'S CERTIFICATION: This water well was plugged under my jurisdiction and was completed on (mo/day/yr) <b>9-9-05</b> and this record is true to the best of my knowledge and belief. Kansas Water Well Contractor's License No. <b>531</b> This Water Well Record was completed on (mo/day/yr) <b>9-19-05</b> under the business name of <b>Geotechnical Services, Inc.</b> by (signature) 						
---	--	--	--	--	--	--	--

INSTRUCTIONS: Please fill in blanks and circle the correct answers. Send three copies to Kansas Department of Health and Environment, Bureau of Water, 1000 S W Jackson St., Ste. 420, Topeka, Kansas 66620-0001. Telephone: 785-296-3565. Send one to Water Well Owner and retain one for your records.