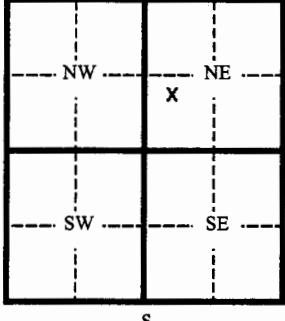


WATER WELL PLUGGING RECORD

Form WWC-5P

KSA 82a-1212

ID No. 00265036

1 LOCATION OF WATER WELL:		Fraction County: Butler NW 1/4 SW 1/4 NE 1/4		Section Number 35	Township Number 25	Range Number 05E	
Distance and direction from nearest town or city street address of well if located within city? 1400 N Main Street	
2 WATER WELL OWNER:		Mark McCabe 2849 West 4 th St. El Dorado, KS 67042		Board of Agriculture, Division of Water Resources Application Number:	
3 MARK WELL'S LOCATON WITH AN "X" IN SECTION BOX:				4 DEPTH OF WELL 19.07	ft. Originally drilled to 19 feet bgs	
WELL'S STATIC WATER LEVEL 10.43 ft.	
WELL WAS USED AS:	
<table border="0"> <tr> <td>1 Domestic</td> <td>5 Public Water Supply</td> <td>9 Dewatering</td> </tr> <tr> <td>2 Irrigation</td> <td>6 Oil Field Water Supply</td> <td>10 Monitoring Well</td> </tr> <tr> <td>3 Feedlot</td> <td>7 Lawn and Garden (domestic)</td> <td>11 Injection Well</td> </tr> <tr> <td>4 Industrial</td> <td>8 Air Conditioning</td> <td>12 Other</td> </tr> </table>							1 Domestic	5 Public Water Supply	9 Dewatering	2 Irrigation	6 Oil Field Water Supply	10 Monitoring Well	3 Feedlot	7 Lawn and Garden (domestic)	11 Injection Well	4 Industrial	8 Air Conditioning	12 Other	
1 Domestic	5 Public Water Supply	9 Dewatering	
2 Irrigation	6 Oil Field Water Supply	10 Monitoring Well	
3 Feedlot	7 Lawn and Garden (domestic)	11 Injection Well	
4 Industrial	8 Air Conditioning	12 Other	
Was a chemical/bacteriological sample submitted to Department? If yes, mo/day/yr sample was submitted Water Well Disinfected: Yes <input checked="" type="checkbox"/> No <input checked="" type="checkbox"/>	
Yes <input type="checkbox"/> No <input checked="" type="checkbox"/>	
5 TYPE OF BLANK CASING USED:	
<table border="0"> <tr> <td>1 Steel</td> <td>3 RMP (SR)</td> <td>5 Wrought</td> <td>7 Fiberglass</td> <td>9 Other (specify below)</td> </tr> <tr> <td><input checked="" type="checkbox"/> 2 PVC</td> <td>4 ABC</td> <td>6 Asbestos-Cement</td> <td>8 Concrete Tile</td> <td></td> </tr> </table>							1 Steel	3 RMP (SR)	5 Wrought	7 Fiberglass	9 Other (specify below)	<input checked="" type="checkbox"/> 2 PVC	4 ABC	6 Asbestos-Cement	8 Concrete Tile	
1 Steel	3 RMP (SR)	5 Wrought	7 Fiberglass	9 Other (specify below)	
<input checked="" type="checkbox"/> 2 PVC	4 ABC	6 Asbestos-Cement	8 Concrete Tile	
Blank casing diameter <u>2</u> in. Was casing pulled? Yes <input checked="" type="checkbox"/> No <input type="checkbox"/> If yes, how much <u>19 feet</u>	
Casing height above or below land surface _____ in. Overdrilled to 19 feet below ground surface	
6 GROUT PLUG MATERIAL: 1 Neat cement 2 Cement grout 3 Bentonite 4 Other	
Grout Plug Intervals From <u>2</u> ft. to <u>19</u> ft. From _____ ft. to _____ ft. From _____ ft. to _____ ft.	
What is the nearest source of possible contamination:	
<table border="0"> <tr> <td>1 Septic tank</td> <td>6 Seepage pit</td> <td>11 Fuel storage</td> <td>16 Other (specify below)</td> </tr> <tr> <td>2 Sewer lines</td> <td>7 Pit privy</td> <td>12 Fertilizer storage</td> <td></td> </tr> <tr> <td>3 Watertight sewer lines</td> <td>8 Sewage lagoon</td> <td>13 Insecticide storage</td> <td></td> </tr> <tr> <td>4 Lateral lines</td> <td>9 Feedyard</td> <td>14 Abandoned water well</td> <td></td> </tr> <tr> <td>5 Cess Pool</td> <td>10 Livestock pens</td> <td>15 Oil well/ Gas well</td> <td></td> </tr> </table>							1 Septic tank	6 Seepage pit	11 Fuel storage	16 Other (specify below)	2 Sewer lines	7 Pit privy	12 Fertilizer storage		3 Watertight sewer lines	8 Sewage lagoon	13 Insecticide storage		4 Lateral lines	9 Feedyard	14 Abandoned water well		5 Cess Pool	10 Livestock pens	15 Oil well/ Gas well																																					
1 Septic tank	6 Seepage pit	11 Fuel storage	16 Other (specify below)	
2 Sewer lines	7 Pit privy	12 Fertilizer storage	
3 Watertight sewer lines	8 Sewage lagoon	13 Insecticide storage	
4 Lateral lines	9 Feedyard	14 Abandoned water well	
5 Cess Pool	10 Livestock pens	15 Oil well/ Gas well	
Direction from well? _____ How many feet? _____	
<table border="1"> <thead> <tr> <th>FROM</th> <th>TO</th> <th>CODE</th> <th colspan="4">PLUGGING MATERIALS</th> </tr> </thead> <tbody> <tr> <td>0</td> <td>2</td> <td>Soil</td> <td colspan="4"></td> </tr> <tr> <td>19</td> <td></td> <td>Bentonite</td> <td colspan="4"></td> </tr> <tr> <td></td> <td></td> <td></td> <td colspan="4"></td> </tr> </tbody> </table>							FROM	TO	CODE	PLUGGING MATERIALS				0	2	Soil					19		Bentonite																																							
FROM	TO	CODE	PLUGGING MATERIALS	
0	2	Soil	
19		Bentonite	

7	CONTRACTOR'S OR LANDOWNER'S CERTIFICATION: This water well was plugged under my jurisdiction and was completed on (mo/day/yr) <u>9-9-05</u> and this record is true to the best of my knowledge and belief. Kansas Water Well Contractor's License No. <u>531</u> This Water Well Record was completed on (mo/day/yr) <u>9-19-05</u> under the business name of <u>Geotechnical Services, Inc.</u> by (signature) <u>Alvin G. Miller</u>					
---	--	--	--	--	--	--

INSTRUCTIONS: Please fill in blanks and circle the correct answers. Send three copies to Kansas Department of Health and Environment, Bureau of Water, 1000 S W Jackson St., Ste. 420, Topeka, Kansas 66620-0001. Telephone: 785-296-3565. Send one to Water Well Owner and retain one for your records.