

AGES - GARY

WATER WELL RECORD Form WWC-5 KSA 82a-1212

SB-4

1 LOCATION OF WATER WELL:

County: Butler

Fraction

SW 1/4 SW 1/4 SE 1/4

Section Number

35

Township Number

T 25 S

Range Number

R 5E EW

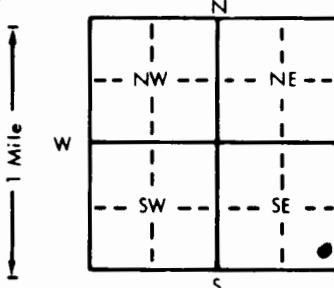
Distance and direction from nearest town or city street address of well if located within city?

2 WATER WELL OWNER: DillonsRR#, St. Address, Box #: 6TH & Main StreetsCity, State, ZIP Code: EL Dorado, KS 67042

Board of Agriculture, Division of Water Resources

Application Number:

3 LOCATE WELL'S LOCATION WITH AN "X" IN SECTION BOX:

4 DEPTH OF COMPLETED WELL 20 ft. ELEVATION:

Depth(s) Groundwater Encountered 1. ft. 2. ft. 3. ft.

WELL'S STATIC WATER LEVEL 16 ft. below land surface measured on mo/day/yr

Pump test data: Well water was ft. after hours pumping gpm

Est. Yield gpm: Well water was ft. after hours pumping gpm

Bore Hole Diameter in. to ft. and in. to ft.

WELL WATER TO BE USED AS: 5 Public water supply 8 Air conditioning 11 Injection well

1 Domestic 3 Feedlot 6 Oil field water supply 9 Dewatering 12 Other (Specify below)

2 Irrigation 4 Industrial 7 Lawn and garden only 10 Monitoring well SOTL Boring

Was a chemical/bacteriological sample submitted to Department? Yes No If yes, mo/day/yr sample was submitted

Water Well Disinfected? Yes No

5 TYPE OF BLANK CASING USED:

1 Steel 3 RMP (SR)
2 PVC 4 ABS

5 Wrought iron

8 Concrete tile

CASING JOINTS: Glued Clamped

6 Asbestos-Cement 9 Other (specify below) Welded

7 Fiberglass Threaded

Blank casing diameter in. to ft., Dia in. to ft., Dia in. to ft.

Casing height above land surface in., weight lbs./ft. Wall thickness or gauge No.

TYPE OF SCREEN OR PERFORATION MATERIAL:

1 Steel 3 Stainless steel 5 Fiberglass 7 PVC 10 Asbestos-cement
2 Brass 4 Galvanized steel 6 Concrete tile 9 ABS 11 Other (specify)

SCREEN OR PERFORATION OPENINGS ARE:

5 Gauzed wrapped 8 Saw cut 11 None (open hole)
6 Wire wrapped 9 Drilled holes 10 Other (specify)1 Continuous slot 3 Mill slot
2 Louvered shutter 4 Key punched

7 Torch cut

SCREEN-PERFORATED INTERVALS: From ft. to ft., From ft. to ft.

From ft. to ft., From ft. to ft.

GRAVEL PACK INTERVALS: From ft. to ft., From ft. to ft.

From ft. to ft., From ft. to ft.

6 GROUT MATERIAL: 1 Neat cement 2 Cement grout 3 Bentonite 4 Other

Grout Intervals: From ft. to ft., From ft. to ft., From ft. to ft.

What is the nearest source of possible contamination:

10 Livestock pens 14 Abandoned water well
11 Fuel storage 15 Oil well/Gas well
12 Fertilizer storage 16 Other (specify below)
13 Insecticide storage

1 Septic tank 4 Lateral lines 7 Pit privy

2 Sewer lines 5 Cess pool 8 Sewage lagoon

3 Watertight sewer lines 6 Seepage pit 9 Feedyard

Direction from well? How many feet?

FROM	TO	LITHOLOGIC LOG	FROM	TO	PLUGGING INTERVALS
0	3	<u>Brown Clay</u>	0	1	<u>Concrete</u>
3	9	<u>Black Clay</u>	1	4	<u>Dirt</u>
9	20	<u>Red Brown Clay</u>	4	14	<u>Concrete</u>
			14	20	<u>Hole plug</u>

7 CONTRACTOR'S OR LANDOWNER'S CERTIFICATION: This water well was (1) constructed, (2) reconstructed, or (3) plugged under my jurisdiction and was completed on (mo/day/year) 7-16-97 and this record is true to the best of my knowledge and belief. KansasWater Well Contractor's License No. 607 This Water Well Record was completed on (mo/day/year) 8-5-97under the business name of Davis Environmental Drilling L.L.C. by (signature) John Davis

INSTRUCTIONS: Use typewriter or ball point pen. PLEASE PRESS FIRMLY and PRINT clearly. Please fill in blanks, underline or circle the correct answers. Send top three copies to Kansas Department of Health and Environment, Bureau of Water, Topeka, Kansas 66620-0001. Telephone: 913-296-5545. Send one to WATER WELL OWNER and retain one for your records.