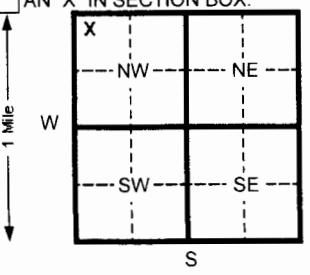
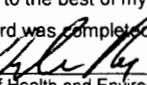


1 LOCATION OF WATER WELL: County: <b>Butler</b>		Fraction <b>NW 1/4 NW 1/4 NW 1/4</b>	Section Number <b>35</b>	Township Number <b>T 25 S</b>	Range Number <b>R 5 E</b>	
Distance and direction from nearest town or city street address of well if located within city? <b>1800 N. Topeka – El Dorado</b>						
2 WATER WELL OWNER: <b>El Paso Merchant Energy-Petroleum Company</b>						
RR#, St. Address, Box # : <b>2 N. Nevada</b>		Board of Agriculture, Division of Water Resources				
City, State, ZIP Code : <b>Colorado Springs, CO 80903</b>		Application Number: _____				
3 LOCATE WELL'S LOCATON WITH AN "X" IN SECTION BOX:  		4 DEPTH OF COMPLETED WELL Depth(s) Groundwater Encountered <b>1 12.5</b> ft. 2 ft. 3 ft. WELL'S STATIC WATER LEVEL ft. below land surface measured on mo/day/yr Pump test data: Well water was ft. after hours pumping gpm Est. Yield gpm: Well water was ft. after hours pumping gpm Bore Hole Diameter <b>8</b> in. to <b>20</b> ft. and in. to ft. WELL WATER TO BE USED AS: 5 Public water supply 8 Air conditioning 11 Injection well 1 Domestic 3 Feed lot 6 Oil field water supply 9 Dewatering 12 Other (Specify below) 2 Irrigation 4 Industrial 7 Lawn and garden (domestic) <b>10 Monitoring well</b>				
Was a chemical/bacteriological sample submitted to Department? Yes <input checked="" type="checkbox"/> No <input type="checkbox"/> If yes, mo/day/yr sample was submitted Water Well Disinfected? Yes <input type="checkbox"/> No <input checked="" type="checkbox"/>						
5 TYPE OF BLANK CASING USED: 1 Steel 3 RMP (SR) 5 Wrought Iron 8 Concrete tile Casing Joints: Glued _____ Clamped _____ 2 PVC 4 ABS 6 Asbestos-Cement 9 Other (specify below) Welded _____ Blank casing diameter <b>2</b> in. to <b>10</b> ft., Dia in. to ft., Dia in. to ft. Casing height above land surface <b>Flush</b> in., weight <b>0.703</b> lbs./ft. Wall thickness or gauge No. <b>SCH. 40</b>						
TYPE OF SCREEN OR PERFORATION MATERIAL: 1 Steel 3 Stainless steel 5 Fiberglass 8 RMP (SR) 11 Other (specify) 2 Brass 4 Galvanized steel 6 Concrete tile 9 ABS 12 None used (open hole) SCREEN OR PERFORATION OPENINGS ARE: 1 Continuous slot 3 Mill slot 5 Gauzed wrapped 8 Saw cut 11 None (open hole) 2 Louvered shutter 4 Key punched 6 Wire wrapped 9 Drilled holes 10 Other (specify)						
SCREEN-PERFORATED INTERVALS: From <b>10</b> ft. to <b>20</b> ft. From ft. to ft. From ft. to ft. From ft. to ft. GRAVEL PACK INTERVALS: From <b>9</b> ft. to <b>20</b> ft. From ft. to ft. From ft. to ft. From ft. to ft.						
6 GROUT MATERIAL: 1 Neat cement 2 Cement grout 3 Bentonite 4 Other Grout Intervals From <b>1</b> ft. to <b>9</b> ft. From ft. to ft. From ft. to ft. What is the nearest source of possible contamination: 1 Septic tank 4 Lateral lines 7 Pit privy 10 Livestock pens 14 Abandoned water well 2 Sewer lines 5 Cess pool 8 Sewage lagoon 11 Fuel storage 15 Oil well/ Gas well 3 Watertight sewer lines 6 Seepage pit 9 Feedyard 12 Fertilizer storage 16 Other (specify below)						
Direction from well? How many feet?						
FROM	TO	CODE	LITHOLOGIC LOG	FROM	TO	PLUGGING INTERVALS
<b>0.0</b>	<b>2.5</b>	<b>No Recovery</b>				
<b>2.5</b>	<b>12.8</b>	<b>Fat Clay/Lean Clay, strong brown</b>				
<b>12.8</b>	<b>20.0</b>	<b>Limestone, white to light gray, highly weathered</b>				
7 CONTRACTOR'S OR LANDOWNER'S CERTIFICATION: This water well was <b>(1) constructed</b> , <b>(2) reconstructed</b> , or <b>(3) plugged</b> under my jurisdiction and was completed on (mo/day/yr) <b>05/26/09</b>						and this record is true to the best of my knowledge and belief. Kansas
Water Well Contractor's License No. <b>531</b>						This Water Well Record was completed on (mo/day/yr) <b>06/11/09</b>
under the business name of <b>Geotechnical Services Inc.</b>						by (signature) 
INSTRUCTIONS: Please fill in blanks and circle the correct answers. Send three copies to Kansas Department of Health and Environment, Bureau of Water, 1000 S W Jackson St., Ste. 420, Topeka, Kansas 66612-1367. Telephone: 913-296-5545. Send one to WATER WELL OWNER and retain one for your records.						

OFFICE USE ONLY

R

SEC