

TW-40

WATER WELL RECORD


Form WWC-5

Division of Water Resources App. No.

1 LOCATION OF WATER WELL: County: Butler Fraction 1/4 NE 1/4 NW 1/4 NE 1/4 Section Number 34 Township No. T 25 S Range Number R 5 NE W

Street/Rural Address of Well Location; if unknown, distance & direction from nearest town or intersection: Former El Paso Refinery; N. Topeka St. & W. Refinery Rd. El Dorado, KS Global Positioning System (GPS) information: Latitude: 37.83860 Longitude: 96.86480 Elevation: 1338

2 WATER WELL OWNER: El Paso Corporation RR#, Street Address, Box #: 2 North Nevada City, State, ZIP Code : Colorado Springs, CO 80903 Collection Method: GPS unit (Make/Model: Garmin 60)

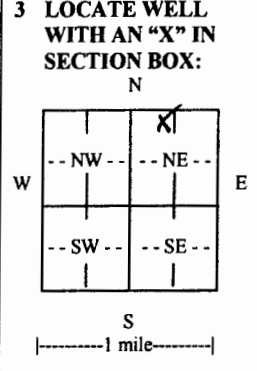

4 DEPTH OF COMPLETED WELL: 29 ft. Depth(s) Groundwater Encountered (1) 24 ft. (2) ft. (3) ft. WELL'S STATIC WATER LEVEL 16 ft. below land surface measured on mo/day/yr 2/14/08

5 TYPE OF CASING USED: Steel PVC Other CASING JOINTS: Glued Clamped Welded Threaded Casing diameter 2 in. to 19 ft. Diameter 19 in. to ft. Casing height above land surface 30 in., Weight lbs./ft., Wall thickness or gauge No. Sch. 40

6 GROUT MATERIAL: Neat cement Cement grout Bentonite Other Grout Intervals: From 17 ft. to 1 ft., From ft. to ft., From ft. to ft. What is the nearest source of possible contamination: Septic tank Lateral lines Pit privy Livestock pens Insecticide storage Other (specify below) Former Oil Refinery

Table with columns: FROM, TO, LITHOLOGIC LOG, FROM, TO, LITHO. LOG (cont.) or PLUGGING INTERVALS. Row 1: 0 to 5, silty clay. Row 2: 5 to 29, limestone.

7 CONTRACTOR'S OR LANDOWNER'S CERTIFICATION: This water well was constructed, reconstructed, or plugged under my jurisdiction and was completed on (mo/day/year) 12/5/07 and this record is true to the best of my knowledge and belief. Kansas Water Well Contractor's License No. 527 This Water Well Record was completed on (mo/day/year) 7/18/11 under the business name of GeoCare by (signature) GeoCare

INSTRUCTIONS: Use typewriter or ball point pen. PLEASE PRESS FIRMLY and PRINT clearly. Please fill in blanks and check the correct answers. Send three copies (white, blue, pink) to Kansas Department of Health and Environment, Bureau of Water, Geology Section, 1000 SW Jackson St., Suite 420, Topeka, Kansas 66612-1367. Telephone 785-296-5522. Send one copy to WATER WELL OWNER and retain one for your records. Include fee of \$5.00 for each constructed well. Visit us at http://www.kdheks.gov/waterwell/index.html.