

TW-72

WATER WELL RECORD

Form WWC-5

Division of Water Resources App. No.


1 LOCATION OF WATER WELL: County: Butler Fraction: 1/4 SE 1/4 NE 1/4 SE 1/4 Section Number: 34 Township No.: T 25 S Range Number: R 5 E

Street/Rural Address of Well Location; if unknown, distance & direction from nearest town or intersection: If at owner's address, check here . Former El Paso Refinery; N. Topeka St. & W. Refinery Rd. El Dorado, KS

Global Positioning System (GPS) information: Latitude: 37.83157 (in decimal degrees) Longitude: 96.85884 (in decimal degrees) Elevation: 1226 Datum: WGS 84, NAD 83, NAD 27

2 WATER WELL OWNER: El Paso Corporation RR#, Street Address, Box #: 2 North Nevada City, State, ZIP Code : Colorado Springs, CO 80903

Collection Method: GPS unit (Make/Model: Garmin 60) Digital Map/Photo, Topographic Map, Land Survey Est. Accuracy: <3 m, 3-5 m, 5-15 m, >15 m

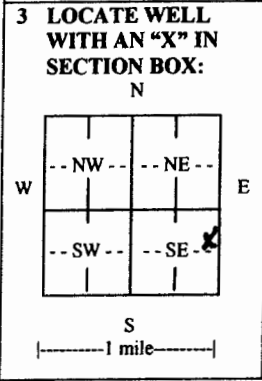

4 DEPTH OF COMPLETED WELL: 14 ft. Depth(s) Groundwater Encountered (1): 12 ft. (2): ft. (3): ft. WELL'S STATIC WATER LEVEL: 10 ft. below land surface measured on mo/day/yr: 2/14/08. Pump test data: Well water was: ft. after: hours pumping: gpm EST. YIELD: gpm Well water was: ft. after: hours pumping: gpm Bore Hole Diameter: 8 in. to 14 ft., and in. to ft. WELL WATER TO BE USED AS: Public water supply Geothermal Injection well Domestic Feedlot Oil field water supply Dewatering Other (Specify below) Irrigation Industrial Domestic-lawn & garden Monitoring well Was a chemical/bacteriological sample submitted to Department? Yes No If yes, mo/day/yr sample was submitted: Water well disinfected? Yes No

5 TYPE OF CASING USED: Steel PVC Other CASING JOINTS: Glued Clamped Welded Threaded Casing diameter: 2 in. to 6 ft., Diameter: in. to ft., Diameter: in. to ft. Casing height above land surface: 30 in., Weight: lbs./ft., Wall thickness or gauge No.: Sch. 40

TYPE OF SCREEN OR PERFORATION MATERIAL: Steel Stainless Steel PVC Other (Specify) Brass Galvanized Steel None used (open hole) SCREEN OR PERFORATION OPENINGS ARE: Continuous slot Mill slot Gauze wrapped Torch cut Drilled holes None (open hole) Louvered shutter Key punched Wire wrapped Saw cut Other (specify) SCREEN-PERFORATED INTERVALS: From: 14 ft. to 6 ft., From: ft. to ft., From: ft. to ft. GRAVEL PACK INTERVALS: From: 14 ft. to 4 ft., From: ft. to ft., From: ft. to ft.

6 GROUT MATERIAL: Neat cement Cement grout Bentonite Other Grout Intervals: From: 4 ft. to 1 ft., From: ft. to ft., From: ft. to ft. What is the nearest source of possible contamination: Septic tank Lateral lines Pit privy Livestock pens Insecticide storage Other (specify below) Sewer lines Cesspool Sewage lagoon Fuel storage Abandoned water well Watertight sewer lines Seepage pit Feedyard Fertilizer storage Oil well/gas well Former Oil Refinery Direction from well Distance from well

FROM	TO	LITHOLOGIC LOG	FROM	TO	LITHO. LOG (cont.) or PLUGGING INTERVALS
0	12	Silty clay			
12	14	limestone			

7 CONTRACTOR'S OR LANDOWNER'S CERTIFICATION: This water well was constructed, reconstructed, or plugged under my jurisdiction and was completed on (mo/day/year) 11/19/07 and this record is true to the best of my knowledge and belief. Kansas Water Well Contractor's License No. 710 This Water Well Record was completed on (mo/day/year) 7/18/11 under the business name of Below Ground Surfaces, Inc. by (signature) [Signature]

INSTRUCTIONS: Use typewriter or ball point pen. PLEASE PRESS FIRMLY and PRINT clearly. Please fill in blanks and check the correct answers. Send three copies (white, blue, pink) to Kansas Department of Health and Environment, Bureau of Water, Geology Section, 1000 SW Jackson St., Suite 420, Topeka, Kansas 66612-1367. Telephone 785-296-5522. Send one copy to WATER WELL OWNER and retain one for your records. Include fee of \$5.00 for each constructed well. Visit us at http://www.kdheks.gov/waterwell/index.html