

TW-12

WATER WELL RECORD


Form WWC-5

Division of Water Resources App. No.

1 LOCATION OF WATER WELL: County: Butler Fraction 1/4 SE 1/4 NW 1/4 SE 1/4 Section Number 34 Township No. T 25 S Range Number R 5 NE W

Street/Rural Address of Well Location; if unknown, distance & direction from nearest town or intersection: El Dorado, KS Global Positioning System (GPS) information: Latitude: 37.83939 Longitude: 96.86482 Elevation: 1292

2 WATER WELL OWNER: El Paso Corporation RR#, Street Address, Box #: 2 North Nevada City, State, ZIP Code : Colorado Springs, CO 80903

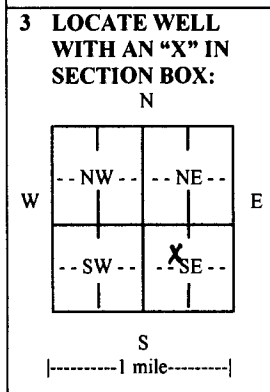

3 LOCATE WELL WITH AN 'X' IN SECTION BOX: 4 DEPTH OF COMPLETED WELL: 20 ft. Depth(s) Groundwater Encountered (1) 9 ft. (2) ... WELL'S STATIC WATER LEVEL 9 ft. below land surface measured on mo/day/yr 2/14/08

5 TYPE OF CASING USED: Steel PVC Other CASING JOINTS: Glued Clamped Welded Threaded Casing diameter 2 in. to 5 ft., Diameter ... Casing height above land surface 30 in., Weight ... lbs./ft., Wall thickness or gauge No. Sch. 40

6 GROUT MATERIAL: Neat cement Cement grout Bentonite Other Grout Intervals: From 3 ft. to 1 ft., From ... ft. to ... ft. What is the nearest source of possible contamination: Septic tank Lateral lines Pit privy Livestock pens Insecticide storage Other (specify below) Former Oil Refinery

Table with 6 columns: FROM, TO, LITHOLOGIC LOG, FROM, TO, LITHO. LOG (cont.) or PLUGGING INTERVALS. Rows contain data for silty clay, clay, fat clay, and limestone.

7 CONTRACTOR'S OR LANDOWNER'S CERTIFICATION: This water well was constructed, reconstructed, or plugged under my jurisdiction and was completed on (mo/day/year) 11/15/07 and this record is true to the best of my knowledge and belief. Kansas Water Well Contractor's License No. 527 This Water Well Record was completed on (mo/day/year) 7/18/11 under the business name of Gea Care by (signature) B. Killam

INSTRUCTIONS: Use typewriter or ball point pen. PLEASE PRESS FIRMLY and PRINT clearly. Please fill in blanks and check the correct answers. Send three copies (white, blue, pink) to Kansas Department of Health and Environment, Bureau of Water, Geology Section, 1000 SW Jackson St., Suite 420, Topeka, Kansas 66612-1367. Telephone 785-296-5522. Send one copy to WATER WELL OWNER and retain one for your records. Include fee of \$5.00 for each constructed well. Visit us at http://www.kdheks.gov/waterwell/index.html.