

WATER WELL PLUGGING RECORD Form WWC-5P KSA 82a-1212 ID NO.

1 LOCATION OF WATER WELL: County: Butler	Fraction $\frac{1}{4} SE \frac{1}{4} NE \frac{1}{4} SE \frac{1}{4}$	Section Number 27	Township Number T 25 S	Range Number S <input checked="" type="checkbox"/> E <input type="checkbox"/> W
---	--	----------------------	---------------------------	--

Street/Rural Address of Well Location; if unknown, distance & direction from nearest town or intersection: If at owner's address, check here Former El Paso Refinery

Global Positioning Systems (GPS) information:

Latitude: 37.8406 (in decimal degrees)Longitude: 96.8564 (in decimal degrees)

Elevation:

Datum: WGS84, NAD83, NAD27

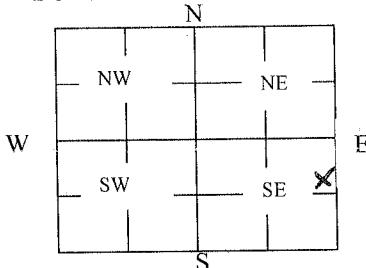
Collection Method:

 GPS unit (Make/Model: Garmin 60cs) Digital Map/Photo, Topographic Map, Land SurveyEst. Accuracy: < 3 m, 3-5 m, 5-15 m, > 15 m

N. Topeka St. & W. Refinery Rd.; El Dorado, KS

2 WATER WELL OWNER: El Paso Corporation
RR#, St. Address, Box #: 2 North Nevada
City, State ZIP Code: Colorado Springs, CO 8090

3 MARK WELL'S LOCATION WITH AN "X" IN SECTION BOX:

4 DEPTH OF WELL 21 ft.WELL'S STATIC WATER LEVEL - ft

WELL WAS USED AS:

Domestic
 Irrigation
 Feedlot
 Industrial

Public Water Supply
 Oil Field Water Supply
 Domestic (Lawn & Garden)
 Air Conditioning

Dewatering
 Monitoring
 Injection Well
 Other _____

Was a chemical/bacteriological sample submitted to Department? Yes No

5 TYPE OF BLANK CASING USED:

Steel RMP (SR) Wrought
 PVC ABS Asbestos-Cement Fiberglass
 Concrete Tile Other (Specify below) _____

Blank casing diameter 2 in. Was casing pulled? Yes No If yes, how much 21Casing height above or below land surface 24 in.6 GROUT PLUG MATERIAL: Neat cement Cement grout Bentonite Other _____Grout Plug Intervals: From 21 ft. to 2 ft., From _____ ft. to _____ ft., From _____ to _____ ft.

What is the nearest source of possible contamination:

Septic tank
 Sewer lines
 Watertight sewer lines
 Lateral lines
 Cess pool

Seepage pit
 Pit privy
 Sewage lagoon
 Feedyard
 Livestock pens

Fuel Storage
 Fertilizer storage
 Insecticide storage
 Abandoned water well
 Oil well/Gas well

 Other (specify below)Former Refinery

Direction from well? _____

How many feet? _____

FROM	TO	PLUGGING MATERIALS	FROM	TO	PLUGGING MATERIALS
<u>21</u>	<u>2</u>	<u>Bentonite</u>			
<u>2</u>	<u>0</u>	<u>Topsoil</u>			

7 CONTRACTOR'S OR LANDOWNER'S CERTIFICATION: This water well was plugged under my jurisdiction and was completed on (mo/day/year) 10/14/11 and this record is true to the best of my knowledge and belief. Kansas Water Well Contractor's License No. 710. This Water Well Record was completed on (mo/day/year) 11-07-11 under the business name of Below Ground Surface, Inc. by (signature) mtm

INSTRUCTIONS: Use typewriter or ballpoint pen. Please press firmly and print clearly. Please fill in blanks, underline or circle the correct answers. Send top three copies to Kansas Department of Health and Environment, Bureau of Water, Geology Section, 1000 SW Jackson St., Ste. 420, Topeka, Kansas 66612-1367. Telephone: 785/296-5524. Send one to Water Well Owner and retain one for your records. Visit us at <http://www.kdheks.gov/waterwell/index.html>.