

1 LOCATION OF WATER WELL: County: BATLER Fraction: SW 1/4 NW 1/4 SW 1/4 Section Number: 26 Township Number: T 25 S Range Number: R 5 E


Distance and direction from nearest town or city street address of well if located within city?

NE OF ELDORADO KS

W 31

2 WATER WELL OWNER: FINA
RR#, St. Address, Box #: PO BOX 2159
City, State, ZIP Code: DALLAS TX 75221
Board of Agriculture, Division of Water Resources
Application Number:

3 LOCATE WELL'S LOCATION WITH AN "X" IN SECTION BOX:

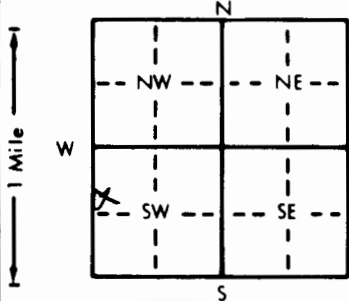

4 DEPTH OF COMPLETED WELL: 15 ft. ELEVATION:






WELL WATER TO BE USED AS: 5 Public water supply 8 Air conditioning 11 Injection well

1 Domestic 3 Feedlot 6 Oil field water supply 9 Dewatering 12 Other (Specify below)

2 Irrigation 4 Industrial 7 Lawn and garden only 10 Monitoring well

Was a chemical/bacteriological sample submitted to Department? Yes No If yes, mo/day/yr sample was submitted

Water Well Disinfected? Yes No

5 TYPE OF BLANK CASING USED: 5 Wrought iron 8 Concrete tile CASING JOINTS: Glued Clamped

1 Steel 3 RMP (SR) 6 Asbestos-Cement 9 Other (specify below) Welded Threaded

2 PVC 4 ABS 7 Fiberglass



TYPE OF SCREEN OR PERFORATION MATERIAL: 7 PVC 10 Asbestos-cement

1 Steel 3 Stainless steel 5 Fiberglass 8 RMP (SR) 11 Other (specify)

2 Brass 4 Galvanized steel 6 Concrete tile 9 ABS 12 None used (open hole)

SCREEN OR PERFORATION OPENINGS ARE: 5 Gauzed wrapped 8 Saw cut 11 None (open hole)

1 Continuous slot 3 Mill slot 6 Wire wrapped 9 Drilled holes

2 Louvered shutter 4 Key punched 7 Torch cut 10 Other (specify)





6 GROUT MATERIAL: 1 Neat cement 2 Cement grout 3 Bentonite 4 Other


What is the nearest source of possible contamination: 10 Livestock pens 14 Abandoned water well

1 Septic tank 4 Lateral lines 7 Pit privy 11 Fuel storage 15 Oil well/Gas well

2 Sewer lines 5 Cess pool 8 Sewage lagoon 12 Fertilizer storage 16 Other (specify below)

3 Watertight sewer lines 6 Seepage pit 9 Feedyard 13 Insecticide storage REFINERY

Direction from well? WITHIN How many feet? 0

FROM TO LITHOLOGIC LOG FROM TO PLUGGING INTERVALS

0 9.5 Sandy clay 0 9.5

9.5 14.5 Sandy clay 9.5 14.5

14.5 15 Limestone 14.5 15

Approved for late submittal by D. Plummer 4.10.91

7 CONTRACTOR'S OR LANDOWNER'S CERTIFICATION: This water well was (1) constructed, (2) reconstructed, or (3) plugged under my jurisdiction and was

completed on (mo/day/year) 10/9/90 and this record is true to the best of my knowledge and belief. Kansas

Water Well Contractor's License No. 102 This Water Well Record was completed on (mo/day/yr) 4/9/91

under the business name of Daynewestern Co Inc by (signature) [Signature]