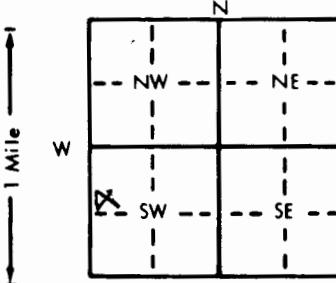


WATER WELL RECORD Form WWC-5 KSA 82a-1212

1 LOCATION OF WATER WELL:		Fraction County: BUTLER Distance and direction from nearest town or city street address of well if located within city?	Section Number T 25 S	Township Number R 5 E	Range Number
2 WATER WELL OWNER:		FINA RR#, St. Address, Box # : PO BOX 2159		Board of Agriculture, Division of Water Resources Application Number:	
3 LOCATE WELL'S LOCATION WITH AN "X" IN SECTION BOX:		4 DEPTH OF COMPLETED WELL..... 27 ft. ELEVATION:	
		Depth(s) Groundwater Encountered 1..... ft. 2..... ft. 3..... ft. WELL'S STATIC WATER LEVEL 11 ft. below land surface measured on mo/day/yr 10/11/90 Pump test data: Well water was ft. after hours pumping gpm Est. Yield gpm: Well water was ft. after hours pumping gpm Bore Hole Diameter in. to WELL WATER TO BE USED AS: 5 Public water supply 8 Air conditioning 11 Injection well 1 Domestic 3 Feedlot 6 Oil field water supply 9 Dewatering 12 Other (Specify below) 2 Irrigation 4 Industrial 7 Lawn and garden only 10 Monitoring well			
		Was a chemical/bacteriological sample submitted to Department? Yes.....No..... If yes, mo/day/yr sample was submitted		Water Well Disinfected? Yes Yes No ✓	
5 TYPE OF BLANK CASING USED:		1 Steel ✓ PVC	3 RMP (SR) 4 ABS	5 Wrought iron 6 Asbestos-Cement	8 Concrete tile 9 Other (specify below)
Blank casing diameter	 in. to 17 ft. Dia..... in. to ft. Dia..... in. to ft.	CASING JOINTS: Glued Clamped Welded Threaded ✓	
Casing height above land surface	 24 in., weight	lbs./ft. Wall thickness or gauge No.		
TYPE OF SCREEN OR PERFORATION MATERIAL:		7 PVC 1 Steel 3 Stainless steel 5 Fiberglass 8 RMP (SR) 10 Asbestos-cement 2 Brass 4 Galvanized steel 6 Concrete tile 9 ABS 11 Other (specify) 12 None used (open hole)			
SCREEN OR PERFORATION OPENINGS ARE:		1 Continuous slot 3 Mill slot 5 Gauzed wrapped 8 Saw cut 11 None (open hole) 2 Louvered shutter 4 Key punched 6 Wire wrapped 9 Drilled holes 7 Torch cut 10 Other (specify)			
SCREEN-PERFORATED INTERVALS:		From..... 17 ft. to 27 ft., From..... ft. to ft.	From..... ft. to ft., From..... ft. to ft.		
GRAVEL PACK INTERVALS:		From..... 15 ft. to 27 ft., From..... ft. to ft.	From..... ft. to ft., From..... ft. to ft.		
6 GROUT MATERIAL:		1 Neat cement 2 Cement grout	3 Bentonite	4 Other
Grout Intervals:		From..... ft. to 15 ft., From..... ft. to ft., From..... ft. to ft.	From..... ft. to ft., From..... ft. to ft.		
What is the nearest source of possible contamination:		10 Livestock pens 14 Abandoned water well 11 Fuel storage 15 Oil well/Gas well 12 Fertilizer storage 16 Other (specify below) REFINERY 13 Insecticide storage			
Direction from well?		WITHIN			
FROM	TO	LITHOLOGIC LOG	FROM	TO	PLUGGING INTERVALS
19	12	Silty Clay			
12	14	Shale			
14	17	Shale			
17	23	Shale			
23	27	Shale			
Approved for later submittal by D. Plummer 4/10/91					

7 CONTRACTOR'S OR LANDOWNER'S CERTIFICATION: This water well was 1 constructed, 2 reconstructed, or 3 plugged under my jurisdiction and was completed on (mo/day/year) 10/11/90 and this record is true to the best of my knowledge and belief. Kansas Water Well Contractor's License No. 02 This Water Well Record was completed on (mo/day/yr) 4/10/91 by (signature) D. Plummer	
under the business name of Jayne Western	

INSTRUCTIONS: Use typewriter or ball point pen. PLEASE PRESS FIRMLY and PRINT clearly. Please fill in blanks, underline or circle the correct answers. Send top three copies to Kansas Department of Health and Environment, Bureau of Water, Topeka, Kansas 66620-7320. Telephone: 913-296-5545. Send one to WATER WELL OWNER and retain one for your records.