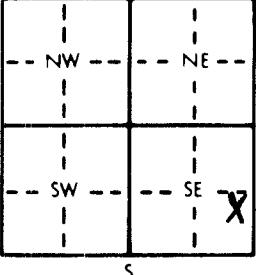


1 LOCATION OF WATER WELL:	Fraction	Section Number	Township Number	Range Number
County: Butler	NE $\frac{1}{4}$ SE $\frac{1}{4}$ SE $\frac{1}{4}$	34	T 25 S	R 5 EW

Distance and direction from nearest town or city street address of well if located within city?
 1/8 mile N. of El Dorado (15D)

2 WATER WELL OWNER:	Pester Corporation	Board of Agriculture, Division of Water Resources
RR#, St. Address, Box #:	P. O. Box 10006	Application Number:
City, State, ZIP Code:	Des Moines, IA 50306	

3 LOCATE WELL'S LOCATION WITH AN "X" IN SECTION BOX:	4 DEPTH OF COMPLETED WELL: 130.0 ft. ELEVATION: 1324.8 GL
	Depth(s) Groundwater Encountered: 12 ft. 2 32 ft. 3 ft.
	WELL'S STATIC WATER LEVEL: 26.9 ft. below land surface measured on mo/day/yr 12-20-86

Pump test data: Well water was ft. after hours pumping gpm
 Est. Yield gpm: Well water was ft. after hours pumping gpm
 Bore Hole Diameter: 3.5 in. to 130 ft. and 75.8 in. to 21 ft. ft.

WELL WATER TO BE USED AS: 5 Public water supply 8 Air conditioning 11 Injection well
 1 Domestic 3 Feedlot 6 Oil field water supply 9 Dewatering 12 Other (Specify below)
 2 Irrigation 4 Industrial 7 Lawn and garden only 10 Observation well

Was a chemical/bacteriological sample submitted to Department? Yes No X If yes, mo/day/yr sample was submitted

Water Well Disinfected? Yes No X

5 TYPE OF BLANK CASING USED:	5 Wrought iron	8 Concrete tile	CASING JOINTS: Glued Clamped X
1 Steel	3 RMP (SR)	6 Asbestos-Cement	Welded
2 PVC	4 ABS	7 Fiberglass	Threaded

Blank casing diameter: 4 in. to 23.5 ft., Dia in. to ft., Dia in. to ft.

Casing height above land surface: 6 in., weight: 2.001 lbs./ft. Wall thickness or gauge No. 237

TYPE OF SCREEN OR PERFORATION MATERIAL:	7 PVC	10 Asbestos-cement
1 Steel	3 Stainless steel	8 RMP (SR)
2 Brass	4 Galvanized steel	9 ABS

SCREEN OR PERFORATION OPENINGS ARE:

1 Continuous slot	3 Mill slot	5 Gauzed wrapped	8 Saw cut	11 None (open hole)
2 Louvered shutter	4 Key punched	6 Wire wrapped	9 Drilled holes	
		7 Torch cut	10 Other (specify)	

SCREEN-PERFORATED INTERVALS: From ft. to ft., From ft. to ft.

GRAVEL PACK INTERVALS: From ft. to ft., From ft. to ft.

From ft. to ft., From ft. to ft.

6 GROUT MATERIAL: 1 Neat cement 2 Cement grout 3 Bentonite 4 Other

Grout Intervals: From 0.0 ft. to 45 ft., From ft. to ft., From ft. to ft.


What is the nearest source of possible contamination:

1 Septic tank	4 Lateral lines	7 Pit privy	10 Livestock pens	14 Abandoned water well
2 Sewer lines	5 Cess pool	8 Sewage lagoon	11 Fuel storage	15 Oil well/Gas well
3 Watertight sewer lines	6 Seepage pit	9 Feedyard	12 Fertilizer storage	16 Other (specify below)

Direction from well? West

How many feet? 200

LITHOLOGIC LOG			LITHOLOGIC LOG		
FROM	TO	DESCRIPTION	FROM	TO	DESCRIPTION
0.0	2.0	Clay, dark gray			
2.0	4.75	Clay, brown			
4.75	5.00	Clay, tan			
5.0	8.5	Limestone weathered			
8.5	20.5	Shale, yellow/brown			
20.5	21.0	Shale, gray/brown			
21.0	24.5	Shale, dark gray			
24.5	34.0	Soft zones			
34.0	90.5	Limestone, gray fractured			
90.5	126.0	Chert			
126.0	130.0	Shale			

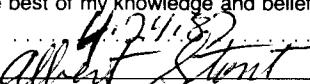7 CONTRACTOR'S OR LANDOWNER'S CERTIFICATION: This water well was (1) constructed, (2) reconstructed, or (3) plugged under my jurisdiction and was completed on (mo/day/year) 10-26-86 and this record is true to the best of my knowledge and belief. Kansas Water Well Contractor's License No. 415 This Water Well Record was completed on (mo/day/yr) 10-24-86 under the business name of Daniels Drilling Co. by (signature) 

INSTRUCTIONS: Use typewriter or ball point pen. PLEASE PRESS FIRMLY and PRINT clearly. Please fill in blanks, underline or circle the correct answers. Send top three copies to Kansas Department of Health and Environment, Bureau of Water Protection, Topeka, Kansas 66620-7320, Telephone: 913-862-9360. Send one to WATER WELL OWNER and retain one for your records.

Table 1
Summary of Monitoring Wells Requiring Transfer of Ownership

Monitoring Location	Proposed Action	Comment
Alluvial/Top of Eroded Fort Riley		
W-26	Transfer to KM	W-26 was constructed on Dec 3, 1986 (Pester Corp). The well was not monitored for the Pester RI. Currently included in Kinder Morgan gauging/monitoring program
Fort Riley Aquifer		
W-15S	Transfer to KM	W-15S was constructed on Dec 8, 1986 (Pester Corp). The well was not monitored in the Pester RI. Currently included in Kinder Morgan gauging/monitoring program.
W-16S (W-16)	Transfer to KM	W-16 was constructed on Nov 24, 1986 (Pester Corp). The well was not monitored for the Pester RI.
Florence Aquifer		
W-01D	To be Abandoned	W-01D was constructed on Dec 3, 1986 (Pester Corp).
W-15D	To be Abandoned	W-15D was constructed on Oct 26, 1986 (Pester Corp).