


1 LOCATION OF WATER WELL:	Fraction	Section Number	Township Number	Range Number
County: <b>Butler</b>	<del>NE</del> $\frac{1}{4}$ <b>NE</b> $\frac{1}{4}$ <b>NE</b> $\frac{1}{4}$	<b>33</b>	<b>T - 25 - S</b>	<b>R - 5 - E</b>

Distance and direction from nearest town or city street address of well if located within city?

1651 Pennsylvania

2	WATER WELL OWNER:	<b>James McKay</b>	
	RR#, St. Address, Box # :	<b>1651 Pennsylvania</b>	Board of Agriculture, Division of Water Resources
	City, State, ZIP Code :	<b>Eldorado Kansas 67042</b>	Application Number:

3 LOCATE WELL'S LOCATION WITH AN "X" IN SECTION BOX: 4 DEPTH OF COMPLETED WELL: 100' ft. ELEVATION: 331'

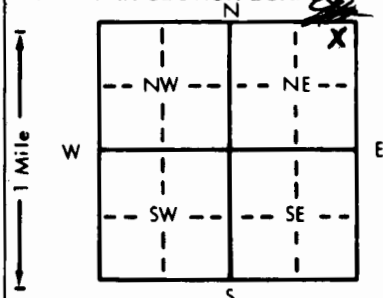

4 DEPTH OF COMPLETED WELL. **100'** ft. ELEVATION: .....  
 Depth(s) Groundwater Encountered 1. **64'** ft. 2. **92'** ft. 3. .... ft.  
 WELL'S STATIC WATER LEVEL **38'** ft. below land surface measured on mo/day/yr .....  
 Pump test data: Well water was ..... ft. after ..... hours pumping ..... gpm  
 Est. Yield **1.00** gpm: Well water was ..... ft. after ..... hours pumping ..... gpm  
 Bore Hole Diameter **1.1"** in. to ..... ft., and ..... in. to ..... ft.  
 WELL WATER TO BE USED AS:  
 1 **Domestic** 3 Feedlot 6 Oil field water supply 9 Dewatering 12 Other (Specify below)  
 2 Irrigation 4 Industrial 7 Lawn and garden only 10 Observation well  
 Was a chemical/bacteriological sample submitted to Department? Yes.....No **X**.....; If yes, mo/day/yr sample was sub-  
 mitted ..... Water Well Disinfected? Yes **X** No

5 TYPE OF BLANK CASING USED:		5 Wrought iron	8 Concrete tile	CASING JOINTS: Glued . . . . . Clamped . . . . .
1 Steel	3 RMP (SR)	6 Asbestos-Cement	9 Other (specify below)	Welded . . . . .
2 PVC	4 Asbestos	7 Fiberglass		Threaded . . . . .

Blank casing diameter 8 in. to \_\_\_\_\_ ft., Dia \_\_\_\_\_ in. to \_\_\_\_\_ ft., Dia \_\_\_\_\_ in. to \_\_\_\_\_ ft.  
Casing height above land surface 18" in., weight \_\_\_\_\_ lbs./ft. Wall thickness or gauge No. \_\_\_\_\_

TYPE OF SCREEN OR PERFORATION MATERIAL:				7 PVC	10 Asbestos-cement
1 Steel	3 Stainless steel	5 Fiberglass	8 RMP (SR)	11 Other (specify) .....	
2 Brass	4 Galvanized steel	6 Concrete tile	9 ABS	12 None used (open hole)	

SCREEN OR PERFORATION OPENINGS ARE:

1 Continuous slot	3 Mill slot	5 Gauzed wrapped	8 Saw cut	11 None (open hole)
2 Louvered shutter	4 Key punched	6 Wire wrapped	9 Drilled holes	
		7 Torch cut	10 Other (specify) .....	

SCREEN-PERFORATED INTERVALS: From 40' ft. to 100' ft., From \_\_\_\_\_ ft. to \_\_\_\_\_ ft.  
From \_\_\_\_\_ ft. to \_\_\_\_\_ ft., From \_\_\_\_\_ ft. to \_\_\_\_\_ ft.

GRAVEL PACK INTERVALS: From 15' ft. to 100' ft., From \_\_\_\_\_ ft. to \_\_\_\_\_ ft.  
From \_\_\_\_\_ ft. to \_\_\_\_\_ ft., From \_\_\_\_\_ ft. to \_\_\_\_\_ ft.

6 GROUT MATERIAL: Neat cement 3' 15' 2 Cement grout 3 Bentonite 4 Other

Grout Intervals: From ft to ft From ft to ft From ft to ft From ft to ft

What is the nearest source of possible contamination:

1 Septic tank	4 Lateral lines	7 Pit privy	10 Livestock pens	14 Abandoned water well
2 Sewer lines	5 Cess pool	8 Sewage lagoon	11 Fuel storage	15 Oil well/Gas well
3 Watertight sewer lines	6 Seepage pit	9 Feedyard	12 Fertilizer storage	16 Other (specify below)
13 Insecticide storage				

Direction from well? **North** How many feet? **18'**

[illegible]

7 CONTRACTOR'S OR LANDOWNER'S CERTIFICATION: This water well was (1) constructed, (2) reconstructed, or (3) plugged under my jurisdiction and was completed on (mo/day/year) June 10, 1981 and this record is true to the best of my knowledge and belief. Kansas Water Well Contractor's License No. 413 This Water Well Record was completed on (mo/day/year) June 21, 1981 under the business name of Tumble Weed Drilling by (signature) Thomas W. Pochter

INSTRUCTIONS: Use typewriter or ball point pen, PLEASE PRESS FIRMLY and PRINT clearly. Please fill in blanks, underline or circle the correct answers. Send top three copies to Kansas Department of Health and Environment, Division of Environment, Environmental Geology Section, Topeka, KS 66620. Send one to WATER WELL OWNER and retain one for your records.