


1 LOCATION OF WATER WELL: County: <u>Butler</u>	Fraction <u>NW 1/4 SE 1/4 SW 1/4</u>	Section Number <u>26</u>	Township Number T <u>25</u> S	Range Number R <u>8</u> E
--	---	-----------------------------	----------------------------------	------------------------------

Distance and direction from nearest town or city street address of well if located within city?

Coastal Ref. Burn PondP-7

2 WATER WELL OWNER: RR#, St. Address, Box # City, State, ZIP Code	<u>FLNA</u> <u>8350 N. Central Expressway</u> <u>Dallas, TEXAS</u>	Board of Agriculture, Division of Water Resources Application Number:
---	--	--

3 LOCATE WELL'S LOCATION WITH AN "X" IN SECTION BOX:	4 DEPTH OF COMPLETED WELL: <u>18</u> ft. ELEVATION: <u>1290.63</u>
--	--

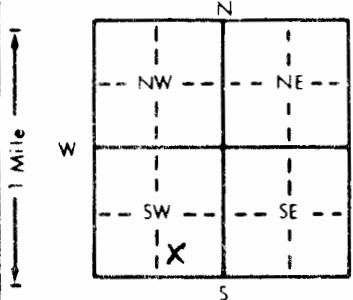

Depth(s) Groundwater Encountered 1. 15 ft. 2. 10.02 ft. 3. 18 ft.


WELL WATER TO BE USED AS: 5 Public water supply 8 Air conditioning 11 Injection well

1 Domestic 3 Feedlot 6 Oil field water supply 9 Dewatering 12 Other (Specify below)

2 Irrigation 4 Industrial 7 Lawn and garden only 10 Monitoring well

Was a chemical/bacteriological sample submitted to Department? Yes No If yes, mo/day/yr sample was submittedWater Well Disinfected? Yes No

5 TYPE OF BLANK CASING USED:	5 Wrought iron	8 Concrete tile	CASING JOINTS: Glued <u>Clamped</u>
------------------------------	----------------	-----------------	-------------------------------------


TYPE OF SCREEN OR PERFORATION MATERIAL:

1 Steel 3 Stainless steel 5 Fiberglass 8 RMP (SR) 10 Asbestos-cement

2 Brass 4 Galvanized steel 6 Concrete tile 9 ABS 11 Other (specify)

SCREEN OR PERFORATION OPENINGS ARE:

1 Continuous slot 3 Mill slot 5 Gauzed wrapped 8 Saw cut 11 None (open hole)

2 Louvered shutter 4 Key punched 6 Wire wrapped 9 Drilled holes

SCREEN-PERFORATED INTERVALS: From 8 ft. to 18 ft. From 8 ft. to 18 ft.GRAVEL PACK INTERVALS: From 6 ft. to 18 ft. From 6 ft. to 18 ft.

6 GROUT MATERIAL:	1 Neat cement	6 Cement grout	3 Bentonite	4 Other
-------------------	---------------	----------------	-------------	---------


What is the nearest source of possible contamination:

1 Septic tank 4 Lateral lines 7 Pit privy 10 Livestock pens 14 Abandoned water well

2 Sewer lines 5 Cess pool 8 Sewage lagoon 11 Fuel storage 15 Oil well/Gas well

3 Watertight sewer lines 6 Seepage pit 9 Feedyard 12 Fertilizer storage 16 Other (specify below)

Direction from well? How many feet?

FROM	TO	LITHOLOGIC LOG	FROM	TO	PLUGGING INTERVALS
------	----	----------------	------	----	--------------------

0 12 Silt & clay13 17 a/a17 18 LS

7 CONTRACTOR'S OR LANDOWNER'S CERTIFICATION: This water well was (1) constructed, (2) reconstructed, or (3) plugged under my jurisdiction and was completed on (mo/day/year)	<u>8-1-94</u>	and this record is true to the best of my knowledge and belief. Kansas
--	---------------	--

Water Well Contractor's License No. 581 This Water Well Record was completed on (mo/day/year)under the business name of Layne, Inc by (signature) Steven R. Mitchell