

1 LOCATION OF WATER WELL: County: <u>Butler</u>		Fraction <u>NW</u> <u>SE</u> <u>1/4</u> <u>SW</u> <u>1/4</u>	Section Number <u>26</u>	Township Number T <u>25</u> S	Range Number R <u>5</u> E
--	--	---	-----------------------------	----------------------------------	------------------------------


Distance and direction from nearest town or city; street address of well if located within city? Coastal Ref. Burn Pond P-6

2 WATER WELL OWNER: FINA
RR#, St. Address, Box # 8350 N. Central Expressway
City, State, ZIP Code Dallas, TX

Board of Agriculture, Division of Water Resources
Application Number:

3 LOCATE WELL'S LOCATION WITH AN "X" IN SECTION BOX: 4 DEPTH OF COMPLETED WELL: 13.5 ft. ELEVATION: _____

Depth(s) Groundwater Encountered: 1 10 ft 2 _____ ft 3 _____ ft

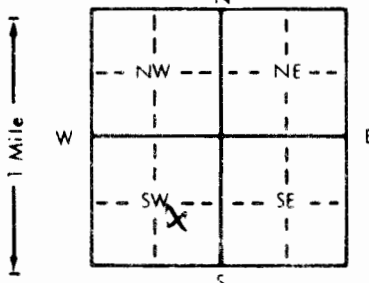

4 DEPTH OF COMPLETED WELL. 13.5 ft. ELEVATION: _____

Depth(s) Groundwater Encountered 1 ft. 10 ft. 2. _____ ft. 3. _____ ft.

WELL'S STATIC WATER LEVEL 7.18 ft. below land surface measured on mo/day/yr _____

Pump test data: Well water was _____ ft. after _____ hours pumping _____ gpm

Est. Yield _____ gpm Well water was _____ ft. after _____ hours pumping _____ gpm

Bore Hole Diameter 6 in. to 13.5 ft. and _____ in. to _____ ft.

WELL WATER TO BE USED AS:

5 Public water supply	8 Air conditioning	11 Injection well		
1 Domestic	3 Feedlot	6 Oil field water supply	9 Dewatering	12 Other (Specify below)
2 Irrigation	4 Industrial	7 Lawn and garden only	10 Monitoring well	

Was a chemical/bacteriological sample submitted to Department? Yes _____ No X; If yes, mo/day/yr sample was submitted _____

Water Well Disinfected? Yes _____ No X

5 TYPE OF BLANK CASING USED:		5 Wrought iron	8 Concrete tile	CASING JOINTS: Glued		Clamped
1 Steel	3 RMP (SR)	6 Asbestos-Cement	9 Other (specify below)	Welded		
2 PVC	4 ABS	7 Fiberglass		Threaded		X
Blank casing diameter		1 in. to 3.5 ft, Dia	in. to		ft, Dia	in. to ft
Casing height above land surface		48 in. weight	13	lbs. ft. Wall thickness or gauge No.		

TYPE OF SCREEN OR PERFORATION MATERIAL:				
1 Steel	3 Stainless steel	5 Fiberglass	7 PVC	10 Asbestos-cement
2 Brass	4 Galvanized steel	6 Concrete tile	8 RMP (SR)	11 Other (specify)
			9 ABS	12 None used (open hole)

SCREEN OR PERFORATION OPENINGS ARE:

1 Continuous slot	3 Mill slot	5 Gauzed wrapped	8 Saw cut	11 None (open hole)
2 Louvered shutter	4 Key punched	6 Wire wrapped	9 Drilled holes	
		7 Torch cut	10 Other (specify)	

SCREEN-PERFORATED INTERVALS:	From	ft. to	ft. From	ft. to	ft.
	From	ft. to	ft. From	ft. to	ft.
GRAVEL PACK INTERVALS:	From	ft. to	ft. From	ft. to	ft.
	From	ft. to	ft. From	ft. to	ft.

6 GROUT MATERIAL: 1 Neat cement 2 Cement grout 3 Bentonite 4 Other

Grout Intervals: From 0 ft. to 2.5 ft. From ft. to ft. From ft. to ft.

What is the nearest source of possible contamination:			10 Livestock pens	14 Abandoned water well
1 Septic tank	4 Lateral lines	7 Pit privy	11 Fuel storage	15 Oil well/Gas well
2 Sewer lines	5 Cess pool	8 Sewage lagoon	12 Fertilizer storage	16 Other (specify below)
3 Watertight sewer lines	6 Seepage pit	9 Feedyard	13 Insecticide storage
Direction from well?			How many feet?	

[illegible]

7. CONTRACTOR'S OR LANDOWNER'S CERTIFICATION: This water well was (1) constructed, (2) reconstructed, or (3) plugged under my jurisdiction and was completed on (mo/day/year) 8-1-94 and this record is true to the best of my knowledge and belief. Kansas Water Well Contractor's License No. 581 This Water Well Record was completed on (mo/day/yr) 8-2-94 under the business name of Layne, Inc. by (signature) Steven R. Mitchell