

1. LOCATION OF WATER WELL:		Fraction	Section Number	Township Number	Range Number
County: <u>Butler</u>		<u>NW</u> $\frac{1}{4}$ <u>SE</u> $\frac{1}{4}$ <u>SW</u> $\frac{1}{4}$	<u>26</u>	T <u>25</u> S	R <u>5</u> <u>E</u>


Distance and direction from nearest town or city street address of well if located within city? Coastal Rif Burn Pond W 36 S

2 WATER WELL OWNER: FMA
RR#, St. Address, Box # : 2352 N. Central Expressway
City, State, ZIP Code : Dallas, TX 75208

Board of Agriculture, Division of Water Resources
Application Number:

3 LOCATE WELL'S LOCATION WITH AN "X" IN SECTION BOX: 4 DEPTH OF COMPLETED WELL: 20 ft. ELEVATION: 147.20

Depth(s) Groundwater Encountered 1. ft. 2. ft. 3. ft.

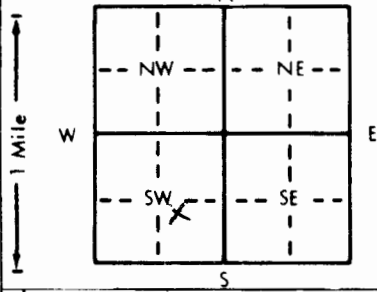

4 DEPTH OF COMPLETED WELL 20 ft. ELEVATION: 1457.20

Depth(s) Groundwater Encountered 1. 27.5 ft. 2. 27.5 ft. 3. 27.5 ft.

WELL'S STATIC WATER LEVEL 27.5 ft. below land surface measured on mo/day/yr

Pump test data: Well water was 28 ft. after 12 hours pumping 16.5 gpm

Est. Yield 6 gpm: Well water was 28 ft. after 12 hours pumping 16.5 gpm

Bore Hole Diameter 6 in. to 28 ft. and 12 in. to 16.5 ft.

WELL WATER TO BE USED AS:

1 Domestic	3 Feedlot	6 Oil field water supply	9 Dewatering	12 Other (Specify below)
2 Irrigation	4 Industrial	7 Lawn and garden only	10 Monitoring well	

Was a chemical/bacteriological sample submitted to Department? Yes X No X; If yes, mo/day/yr sample was submitted 1

Water Well Disinfected? Yes X No X

5 TYPE OF BLANK CASING USED: 1 Steel 3 RMP (SR) 5 Wrought iron 8 Concrete tile CASING JOINTS: Glued Clamped
2 PVC 4 ABS 6 Asbestos-Cement 9 Other (specify below) Welded X
7 Fiberglass Threaded
Blank casing diameter 8 in. to 16 ft. Dia 2 in. to 28 ft. Dia
Casing height above land surface 24 in. weight 169 lbs./ft. Wall thickness or gauge No.

TYPE OF SCREEN OR PERFORATION MATERIAL:				
1 Steel	3 Stainless steel	5 Fiberglass	7 PVC	10 Asbestos-cement
2 Brass	4 Galvanized steel	6 Concrete tile	8 RMP (SR)	11 Other (specify)
			9 ABS	12 None used (open hole)

SCREEN OR PERFORATION OPENINGS ARE:

1 Continuous slot	3 Mill slot	5 Gauzed wrapped	8 Saw cut	11 None (open hole)
2 Louvered shutter	4 Key punched	6 Wire wrapped	9 Drilled holes	
		7 Torch cut	10 Other (specify)	

SCREEN-PERFORATED INTERVALS:	From	12	ft. to	28	ft., From	ft. to	ft.
	From		ft. to		ft., From	ft. to	ft.
GRAVEL PACK INTERVALS:	From	14	ft. to	28	ft., From	ft. to	ft.
	From		ft. to		ft., From	ft. to	ft.

6 GROUT MATERIAL: 1 Neat cement 2 Cement grout 3 Bentonite 4 Other
Grout Intervals: From 0 ft. to 4 ft. From ft. to ft. From ft. to ft.

What is the nearest source of possible contamination:			10 Livestock pens	14 Abandoned water well
1 Septic tank	4 Lateral lines	7 Pit privy	11 Fuel storage	15 Oil well/Gas well
2 Sewer lines	5 Cess pool	8 Sewage lagoon	12 Fertilizer storage	16 Other (specify below)
3 Watertight sewer lines	6 Seepage pit	9 Feedyard	13 Insecticide storage

Direction from well?		How many feet?	
SS	SS		

[illegible]

7. CONTRACTOR'S OR LANDOWNER'S CERTIFICATION: This water well was (1) constructed, (2) reconstructed, or (3) plugged under my jurisdiction and was completed on (mo/day/year) 8-1-94 and this record is true to the best of my knowledge and belief. Kansas Water Well Contractor's License No. 581 This Water Well Record was completed on (mo/day/year) 8-2-94 under the business name of Layne, Inc. by (signature) Steven R. Mitchell