

1 LOCATION OF WATER WELL:

Fraction

NE  $\frac{1}{4}$  SE  $\frac{1}{4}$  NE  $\frac{1}{4}$ 

Section Number

34

Township Number

T 25 S

Range Number

R 6 E

County: Butler Distance and direction from nearest town or city street address of well if located within city?

5 E X 2 N of Eldorado Kan

2 WATER WELL OWNER:

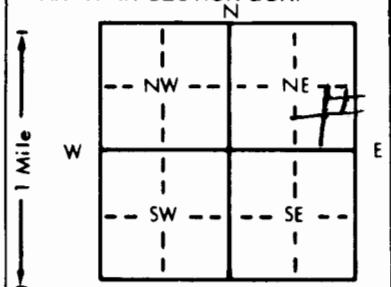
Jack Glaze Suite 600  
120 S. Market Witchita Kan

67202

Board of Agriculture, Division of Water Resources  
Application Number:

RR#, St. Address, Box #

City, State, ZIP Code

3 LOCATE WELL'S LOCATION WITH  
AN "X" IN SECTION BOX:4 DEPTH OF COMPLETED WELL 165 ft. ELEVATION: .....Depth(s) Groundwater Encountered 185 ft. 2 ..... ft. 3 ..... ft.WELL'S STATIC WATER LEVEL 60 ft. below land surface measured on mo/day/yr

Pump test data: Well water was ..... ft. after ..... hours pumping ..... gpm

Est. Yield 100 gpm Well water was ..... ft. after ..... hours pumping ..... gpm

Bore Hole Diameter ..... in. to ..... ft., and ..... in. to ..... ft.

WELL WATER TO BE USED AS: 5 Public water supply 8 Air conditioning 11 Injection well

1 Domestic 3 Feedlot 6 Oil field water supply 9 Dewatering 12 Other (Specify below)

2 Irrigation 4 Industrial 7 Lawn and garden only 10 Monitoring well

Was a chemical/bacteriological sample submitted to Department? Yes ..... No X; If yes, mo/day/yr sample was submittedWater Well Disinfected? Yes X No

5 TYPE OF BLANK CASING USED:

1 Steel 1 PVC 3 RMP (SR) 4 ABS

5 Wrought iron

8 Concrete tile

CASING JOINTS: Glued X Clamped .....

6 Asbestos-Cement

9 Other (specify below)

Welded .....

7 Fiberglass

Threaded .....

Blank casing diameter 5 in. to 40 ft. Dia ..... in. to ..... ft. Dia ..... in. to ..... ft.Casing height above land surface 18 in., weight 160 lbs./ft. Wall thickness or gauge No. 214

TYPE OF SCREEN OR PERFORATION MATERIAL:

1 Steel 3 Stainless steel 5 Fiberglass 8 RMP (SR)

5 Fiberglass

8 RMP (SR)

10 Asbestos-cement

2 Brass 4 Galvanized steel 6 Concrete tile 9 ABS

9 ABS

11 Other (specify) .....

12 None used (open hole)

SCREEN OR PERFORATION OPENINGS ARE:

1 Continuous slot 3 Mill slot 5 Gauzed wrapped 8 Saw cut 11 None (open hole)

5 Gauzed wrapped

6 Wire wrapped

7 Torch cut

8 Saw cut

9 Drilled holes

10 Other (specify) .....

SCREEN-PERFORATED INTERVALS: From 40 ft. to 165 ft. From ..... ft. to ..... ft. From ..... ft. to ..... ft.

From ..... ft. to ..... ft. From ..... ft. to ..... ft. From ..... ft. to ..... ft.

GRAVEL PACK INTERVALS: From ..... ft. to ..... ft. From ..... ft. to ..... ft. From ..... ft. to ..... ft.

From ..... ft. to ..... ft. From ..... ft. to ..... ft. From ..... ft. to ..... ft.

6 GROUT MATERIAL: 1 Neat cement 2 Cement grout 3 Bentonite 4 Other .....

Grout Intervals: From 3 ft. to 23 ft. From ..... ft. to ..... ft. From ..... ft. to ..... ft.

What is the nearest source of possible contamination:

1 Septic tank 4 Lateral lines 7 Pit privy 10 Livestock pens 14 Abandoned water well

2 Sewer lines 5 Cess pool 8 Sewage lagoon 11 Fuel storage 15 Oil well/Gas well

3 Watertight sewer lines 6 Seepage pit 9 Feedyard 12 Fertilizer storage 16 Other (specify below)

10 Livestock pens

11 Fuel storage

12 Fertilizer storage

13 Insecticide storage

How many feet? 500

13 Insecticide storage

14 Abandoned water well

15 Oil well/Gas well

16 Other (specify below) .....

Direction from well? N

FROM TO LITHOLOGIC LOG FROM TO PLUGGING INTERVALS

FROM	TO	LITHOLOGIC LOG	FROM	TO	PLUGGING INTERVALS
0	3	Soil			
3	7	Rock			
7	29	Clay			
27	165	Shale & lime			