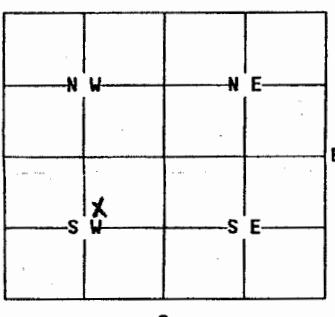


1	LOCATION OF WATER WELL: County: Butler	Fraction SW 1/4 NE 1/4 SW 1/4	Section Number 34	Township Number 25	Range Number 6E																								
Distance and direction from nearest town or city street address of well if located within city?																													
2	WATER WELL OWNER: Richard Griffin RR#, St. Address, Box #: 250 NE Cole Creek Rd. City, State, ZIP Code : El Dorado, KS 67042		Board of Agriculture, Division of Water Resources Application Number:																										
3	MARK WELL'S LOCATION WITH AN "X" IN SECTION BOX: N  S	4	DEPTH OF WELL..... 25.30.....ft.	WELL'S STATIC WATER LEVEL.....∅.....ft.																									
WELL WAS USED AS: <table><tr><td>1 Domestic</td><td>5 Public Water Supply</td><td>9 Dewatering</td></tr><tr><td>2 Irrigation</td><td>6 Oil Field Water Supply</td><td>10 Monitoring Well</td></tr><tr><td>3 Feedlot</td><td>7 Lawn and Garden Only</td><td>11 Injection Well</td></tr><tr><td>4 Industrial</td><td>8 Air Conditioning</td><td>12 Other.....</td></tr></table>						1 Domestic	5 Public Water Supply	9 Dewatering	2 Irrigation	6 Oil Field Water Supply	10 Monitoring Well	3 Feedlot	7 Lawn and Garden Only	11 Injection Well	4 Industrial	8 Air Conditioning	12 Other.....												
1 Domestic	5 Public Water Supply	9 Dewatering																											
2 Irrigation	6 Oil Field Water Supply	10 Monitoring Well																											
3 Feedlot	7 Lawn and Garden Only	11 Injection Well																											
4 Industrial	8 Air Conditioning	12 Other.....																											
Was a chemical/bacteriological sample submitted to Department? Yes....No.... If yes, mo/day/yr sample was submitted.....																													
Water Well Disinfected: Yes..... No.....																													
5	TYPE OF BLANK CASING USED: <table><tr><td>1 Steel</td><td>3 RMP (SR)</td><td>5 Wrought</td><td>7 Fiberglass</td><td>9 Other (specify below) Rock</td></tr><tr><td>2 PVC</td><td>4 ABS</td><td>6 Asbestos-Cement</td><td>8 Concrete Tile</td><td>.....</td></tr></table>					1 Steel	3 RMP (SR)	5 Wrought	7 Fiberglass	9 Other (specify below) Rock	2 PVC	4 ABS	6 Asbestos-Cement	8 Concrete Tile														
1 Steel	3 RMP (SR)	5 Wrought	7 Fiberglass	9 Other (specify below) Rock																									
2 PVC	4 ABS	6 Asbestos-Cement	8 Concrete Tile																									
Blank casing diameter.....in. Was casing pulled? Yes..... No..... If yes, how much..... Casing height above or below land surface.....in.																													
6	GROUT PLUG MATERIAL: 1 Neat cement 2 Cement grout 3 Bentonite 4 Other.....																												
Grout Plug Intervals: From.....ft. to.....ft., From.....ft. toft., From..... to.....ft.																													
What is the nearest source of possible contamination: <table><tr><td>1 Septic tank</td><td>6 Seepage pit</td><td>11 Fuel storage</td><td>16 Other (specify below) Hay land</td></tr><tr><td>2 Sewer lines</td><td>7 Pit privy</td><td>12 Fertilizer storage</td><td>.....</td></tr><tr><td>3 Watertight sewer lines</td><td>8 Sewage lagoon</td><td>13 Insecticide storage</td><td>.....</td></tr><tr><td>4 Lateral lines</td><td>9 Feedyard</td><td>14 Abandoned water well</td><td>.....</td></tr><tr><td>5 Cess Pool</td><td>10 Livestock pens</td><td>15 Oil well/Gas well</td><td>.....</td></tr></table>						1 Septic tank	6 Seepage pit	11 Fuel storage	16 Other (specify below) Hay land	2 Sewer lines	7 Pit privy	12 Fertilizer storage	3 Watertight sewer lines	8 Sewage lagoon	13 Insecticide storage	4 Lateral lines	9 Feedyard	14 Abandoned water well	5 Cess Pool	10 Livestock pens	15 Oil well/Gas well				
1 Septic tank	6 Seepage pit	11 Fuel storage	16 Other (specify below) Hay land																										
2 Sewer lines	7 Pit privy	12 Fertilizer storage																										
3 Watertight sewer lines	8 Sewage lagoon	13 Insecticide storage																										
4 Lateral lines	9 Feedyard	14 Abandoned water well																										
5 Cess Pool	10 Livestock pens	15 Oil well/Gas well																										
Direction from well? How many feet?																													
<table border="1"> <thead> <tr> <th>FROM</th> <th>TO</th> <th>PLUGGING MATERIALS</th> </tr> </thead> <tbody> <tr><td>30'</td><td>27'</td><td>Gravel & Sand</td></tr> <tr><td>27'</td><td>8'</td><td>Fill</td></tr> <tr><td>8'</td><td>4'</td><td>Flag - Bentonite</td></tr> <tr><td>4'</td><td>0'</td><td>Cement grout</td></tr> <tr><td></td><td></td><td></td></tr> <tr><td></td><td></td><td></td></tr> <tr><td></td><td></td><td></td></tr> </tbody> </table>						FROM	TO	PLUGGING MATERIALS	30'	27'	Gravel & Sand	27'	8'	Fill	8'	4'	Flag - Bentonite	4'	0'	Cement grout									
FROM	TO	PLUGGING MATERIALS																											
30'	27'	Gravel & Sand																											
27'	8'	Fill																											
8'	4'	Flag - Bentonite																											
4'	0'	Cement grout																											
7	CONTRACTOR'S OR LANDOWNER'S CERTIFICATION: This water well was plugged under my jurisdiction and was completed on (mo/day/year)..... and this record is true to the best of my knowledge and belief. Kansas Water Well Contractor's License No. This Water Well Record was completed on (mo/day/year)..... under the business name of by (signature)																												