
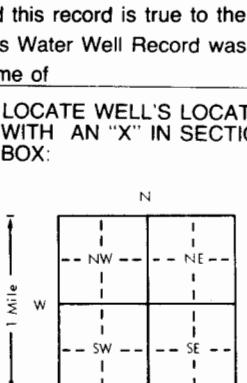


1 LOCATION OF WATER WELL		Fraction				Section Number		Township Number			Range Number			
County: <b>Butler</b>		SW	1/4	SW	1/4	SE	1/4	11	T	25	S	R	6E	E/W
Distance and direction from nearest town or city? <b>10 1/2 Mi NE El Dorado</b>				Street address of well if located within city?										
2 WATER WELL OWNER: <b>Tulsa District Corps of Engineers</b>														
RR#, St. Address, Box # : <b>PO Box 61</b>				Board of Agriculture, Division of Water Resources										
City, State, ZIP Code : <b>Tulsa, Oklahoma 74121</b>				Application Number:										
3 DEPTH OF COMPLETED WELL.....ft. Bore Hole Diameter.....in. to.....ft., and.....in. to.....ft.														
Well Water to be used as:				5 Public water supply			8 Air conditioning			11 Injection well				
1 Domestic	3 Feedlot	6 Oil field water supply	9 Dewatering	12 Other (Specify below)										
2 Irrigation	4 Industrial	7 Lawn and garden only	10 Observation well											
Well's static water level.....ft. below land surface measured on.....				month.....			day.....			year.....				
Pump Test Data				Well water was.....ft. after.....			hours pumping.....			gpm.....				
Est. Yield	gpm:	Well water was.....ft. after.....										gpm.....		
4 TYPE OF BLANK CASING USED:				5 Wrought iron			8 Concrete tile			Casing Joints: Glued.....Clamped.....				
1 Steel	3 RMP (SR)	6 Asbestos-Cement	9 Other (specify below)	Welded.....										
2 PVC	4 ABS	7 Fiberglass		Threaded.....										
Blank casing dia.....in. to.....ft., Dia.....in. to.....ft., Dia.....in. to.....ft.														
Casing height above land surface.....in., weight.....				lbs./ft. Wall thickness or gauge No.....										
TYPE OF SCREEN OR PERFORATION MATERIAL:				5 Fiberglass			7 PVC			10 Asbestos-cement				
1 Steel	3 Stainless steel	6 Concrete tile	9 ABS	11 Other (specify)										
2 Brass	4 Galvanized steel	7 Gauzed wrapped	12 None used (open hole)											
Screen or Perforation Openings Are:				8 RMP (SR)	13 Saw cut	14 None (open hole)								
1 Continuous slot	3 Mill slot	6 Wire wrapped	9 Drilled holes											
2 Louvered shutter	4 Key punched	7 Torch cut	10 Other (specify)											
Screen-Perforation Dia.....in. to.....ft., Dia.....in. to.....ft., Dia.....in. to.....ft.														
Screen-Perforated Intervals: From.....ft. to.....ft., From.....ft. to.....ft., From.....ft. to.....ft.														
Gravel Pack Intervals: From.....ft. to.....ft., From.....ft. to.....ft., From.....ft. to.....ft.														
5 GROUT MATERIAL: 1 Neat cement				2 Cement grout			3 Bentonite			4 Other.....				
Grouted Intervals: From.....ft. to.....ft., From.....ft. to.....ft., From.....ft. to.....ft., From.....ft. to.....ft.														
What is the nearest source of possible contamination:														
1 Septic tank	4 Cess pool	7 Sewage lagoon	10 Fuel storage	14 Abandoned water well										
2 Sewer lines	5 Seepage pit	8 Feed yard	11 Fertilizer storage	15 Oil well/Gas well										
3 Lateral lines	6 Pit privy	9 Livestock pens	12 Insecticide storage	16 Other (specify below)										
Direction from well.....How many feet.....				? Water Well Disinfected? Yes.....No.....										
Was a chemical/bacteriological sample submitted to Department? Yes.....No.....				If yes, date sample										
was submitted.....month.....day.....year: Pump Installed? Yes.....No.....														
If Yes: Pump Manufacturer's name.....				Model No.....HP.....Volts.....										
Depth of Pump Intake.....ft.				Pumps Capacity rated at.....gal./min.										
Type of pump: 1 Submersible				2 Turbine			3 Jet			4 Centrifugal		5 Reciprocating		6 Other.....
6 CONTRACTOR'S OR LANDOWNER'S CERTIFICATION: This water well was (1) constructed, (2) reconstructed, or (3) plugged under my jurisdiction and was completed on..... <b>2</b> .....month..... <b>7</b> .....day..... <b>81</b> .....year.....														
and this record is true to the best of my knowledge and belief. Kansas Water Well Contractor's License No. .... <b>481</b> .....														
This Water Well Record was completed on..... <b>3</b> .....month..... <b>2</b> .....day..... <b>481</b> .....year under the business name of..... <b>Gary Derby</b> .....														
7 LOCATE WELL'S LOCATION WITH AN "X" IN SECTION BOX:		FROM	TO	LITHOLOGIC LOG				FROM	TO	LITHOLOGIC LOG				
														
ELEVATION:														

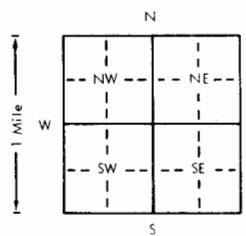

1 ←  
**ELEVATION**


Depth(s) Groundwater Encountered 1. .... ft. 2. .... ft. 3. .... ft. 4. .... ft. (Use a second sheet if needed)

INSTRUCTIONS: Use typewriter or ball point pen, *please press firmly* and *PRINT* clearly. Please fill in blanks, underline or circle the correct answers. Send top three copies to Kansas Department of Health and Environment, Division of Environment, Water Well Contractors, Topeka, KS 66620. Send one to WATER WELL OWNER and retain one for your records.