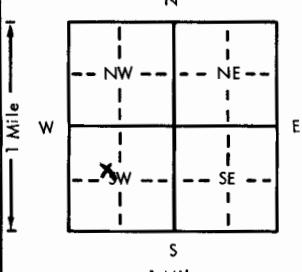


USE TYPEWRITER OR BALL
POINT PEN-PRESS FIRMLY,
PRINT CLEARLY.

WATER WELL RECORD
KSA 82a-1201-1215

Kansas Department of Health and
Environment-Division of Environment
(Water well Contractors)
Topeka, Kansas 66620

SE NW SW

1. Location of well:	County	Fraction $\frac{5}{4} W \frac{1}{4}$	1/4	Section number 11	T <input checked="" type="checkbox"/> 25 s	S <input type="checkbox"/>	R <input type="checkbox"/> R 6 E	E/W	
2. Distance and direction from nearest town or city:	8 miles NE of El Dorado		3. Owner of well:	Louis Jackson Jr. Route 3 El Dorado, Ks. 67042					
Street address of well location if in city:									
4. Locate with "X" in section below:	Sketch map  Well No 2 200 ft well pond								
5. Type and color of material		From	To	6. Bore hole dia. _____ in. Completion date 9-13-75 Well depth 110 ft. 7. <input checked="" type="checkbox"/> Cable tool <input type="checkbox"/> Rotary <input type="checkbox"/> Driven <input type="checkbox"/> Dug <input type="checkbox"/> Hollow rod <input type="checkbox"/> Jetted <input type="checkbox"/> Bored <input type="checkbox"/> Reverse rotary 8. Use: <input type="checkbox"/> Domestic <input type="checkbox"/> Public supply <input type="checkbox"/> Industry <input type="checkbox"/> Irrigation <input type="checkbox"/> Air conditioning <input type="checkbox"/> Stock <input type="checkbox"/> Lawn <input type="checkbox"/> Oil field water <input type="checkbox"/> Other 9. Casing: Material _____ Height: Above or below Threaded <input type="checkbox"/> Welded <input type="checkbox"/> Surface _____ in. RMP _____ PVC _____ Weight _____ lbs./ft. Dia. _____ in. to _____ ft. depth Wall Thickness: inches or Dia. _____ in. to _____ ft. depth gage No. _____ 10. Screen: Manufacturer's name _____ Type _____ Dia. _____ Slot/gauze _____ Length _____ Set between _____ ft. and _____ ft. _____ ft. and _____ ft. Gravel pack? _____ Size range of material _____ 11. Static water level: _____ mo./day/yr. _____ ft. below land surface Date _____ 12. Pumping level below land surfaces: _____ ft. after _____ hrs. pumping _____ g.p.m. _____ ft. after _____ hrs. pumping _____ g.p.m. Estimated maximum yield _____ g.p.m. 13. Water sample submitted: _____ mo./day/yr. Yes <input type="checkbox"/> No <input type="checkbox"/> Date _____ 14. Well head completion: _____ Pitless adapter _____ Inches above grade 15. Well grouted? With: <input type="checkbox"/> Neat cement <input type="checkbox"/> Bentonite <input type="checkbox"/> Concrete Depth: From _____ ft. to _____ ft. 16. Nearest source of possible contamination: ft. _____ Direction _____ Type _____ Well disinfected upon completion? <input type="checkbox"/> Yes <input type="checkbox"/> No _____ 17. Pump: <input type="checkbox"/> Not installed Manufacturer's name _____ Model number _____ HP _____ Volts _____ Length of drop pipe _____ ft. capacity _____ g.p.m. Type: <input type="checkbox"/> Submersible <input type="checkbox"/> Turbine <input type="checkbox"/> Jet <input type="checkbox"/> Reciprocating <input type="checkbox"/> Centrifugal <input type="checkbox"/> Other 18. Elevation: Topography: <input type="checkbox"/> Hill <input checked="" type="checkbox"/> Slope <input type="checkbox"/> Upland <input type="checkbox"/> Valley					
19. Remarks:	Need cement from 50-60 ft. Need cement from 0-10 ft. WELL WAS PLUGGED (Use a second sheet if needed)								
20. Water well contractor's certification: This well was drilled under my jurisdiction and this report is true to the best of my knowledge and belief. Wike Well Driv. 122 Business name _____ License No. _____ Address _____ Signed <u>Murray Wike</u> Date 9-15-75 Authorized representative _____									