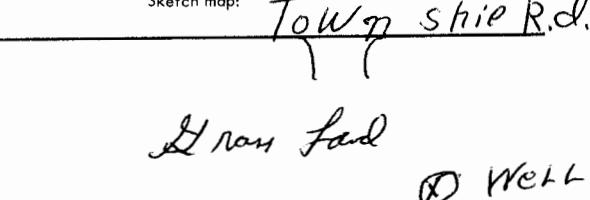


1. Location of well:	County Butler	Fraction NW 1/4 NW 1/4 NW 1/4	Section number 15	Township number T 25 S R 6	Range number 6
2. Distance and direction from nearest town or city:	6 1/2 on 177 from EL DORADO 1/2 MILE		3. Owner of well: WILLIAM HOWARD		
Street address of well location if in city:			R.R. or street: 1861 CIRCLE DR.		
City, state, zip code: EL DORADO, KS 67047					
4. Locate with "X" in section below:	Sketch map: 		6. Bore hole dia. 4 1/2 in. Completion date 7-11-78 Well depth 98 ft.		
	N	E	7. <input type="checkbox"/> Cable tool <input checked="" type="checkbox"/> Rotary <input type="checkbox"/> Driven <input type="checkbox"/> Dug <input type="checkbox"/> Hollow rod <input type="checkbox"/> Jetted <input type="checkbox"/> Bored <input type="checkbox"/> Reverse rotary		
	W	S	8. Use: <input type="checkbox"/> Domestic <input type="checkbox"/> Public supply <input type="checkbox"/> Industry <input type="checkbox"/> Irrigation <input type="checkbox"/> Air conditioning <input checked="" type="checkbox"/> Stock <input type="checkbox"/> Lawn <input type="checkbox"/> Oil field water <input type="checkbox"/> Other		
	1 Mile		9. Casing: Material PVC Height: Above or below Threaded <input type="checkbox"/> Welded <input type="checkbox"/> Surface 14 in. RMP GL Weight 14 lbs./ft.		
5. Type and color of material	From	To	Dia. 5 in. to 88 ft. depth Wall Thickness: inches or Dia. 5 in. to ft. depth gage No. 258		
TOP SOIL	0	1			
LIMESTONE(White)	1	33			
SHALE (GRAY)	33	90			
LIMESTONE(White)	90	98			
			10. Screen: Manufacturer's name M.P.I.		
			Type PVC Dia. 5 Sieve gauze 25/1000 Length 60 Set between 88 ft. and 98 ft. ft. and ft.		
			Gravel pack? yes Size range of material 5/8		
			11. Static water level: 22 ft. below land surface Date 7-11-78		
			12. Pumping level below land surfaces: ft. after hrs. pumping g.p.m. ft. after hrs. pumping g.p.m. Estimated maximum yield 20 g.p.m.		
			13. Water sample submitted: Yes X No Date 7-11-78		
			14. Well head completion: C of P Pitless adapter 14 Inches above grade		
			15. Well grouted? yes With: <input checked="" type="checkbox"/> Neat cement <input type="checkbox"/> Bentonite <input type="checkbox"/> Concrete Depth: From 0 ft. to 11 ft.		
			16. Nearest source of possible contamination: ft. 1000 Direction E Type Creek Well disinfected upon completion? X Yes no		
			17. Pump: Manufacturer's name Model number HP Volts Length of drop pipe ft. capacity g.p.m. Type: <input type="checkbox"/> Submersible <input type="checkbox"/> Turbine <input type="checkbox"/> Jet <input type="checkbox"/> Reciprocating <input type="checkbox"/> Centrifugal <input type="checkbox"/> Other		
			(Use a second sheet if needed)		
18. Elevation:	19. Remarks:				
Topography: <input checked="" type="checkbox"/> Hill <input type="checkbox"/> Slope <input type="checkbox"/> Upland <input type="checkbox"/> Valley					
	20. Water well contractor's certification: This well was drilled under my jurisdiction and this report is true to the best of my knowledge and belief. Prewitt Cons. Co 353 Business name Box 744 License No. Address Austin, KS Signed Austin Prewitt Date 2-11-78 Authorized representative				