

1 LOCATION OF WATER WELL	Fraction	Section Number	Township Number	Range Number
County: Butler	NW 1/4 NE 1/4 NE 1/4	20	T 25 S	R 6E E/W

Distance and direction from nearest town or city?

7 MI NE El Dorado

Street address of well if located within city?

2 WATER WELL OWNER: **Tulsa District Corps of Engineers**RR#, St. Address, Box #: **PO Box 61**

Board of Agriculture, Division of Water Resources

City, State, ZIP Code: **Tulsa, Oklahoma 74121**

Application Number:

3 DEPTH OF COMPLETED WELL: ft. Bore Hole Diameter: in. to ft., and in. to ft.

Well Water to be used as:	5 Public water supply	8 Air conditioning	11 Injection well
1 Domestic	3 Feedlot	6 Oil field water supply	9 Dewatering
2 Irrigation	4 Industrial	7 Lawn and garden only	12 Other (Specify below)
		10 Observation well	

Well's static water level ft. below land surface measured on month day year

Pump Test Data: Well water was ft. after hours pumping. gpm

Est. Yield: gpm: Well water was ft. after hours pumping. gpm

4 TYPE OF BLANK CASING USED: 5 Wrought iron 8 Concrete tile Casing Joints: Glued Clamped

1 Steel 3 RMP (SR) 6 Asbestos-Cement 9 Other (specify below) Welded

2 PVC 4 ABS 7 Fiberglass Threaded

Blank casing dia 6" in. to ft., Dia in. to ft., Dia in. to ft.

Casing height above land surface in., weight lbs./ft. Wall thickness or gauge No

TYPE OF SCREEN OR PERFORATION MATERIAL: 7 PVC 10 Asbestos-cement

1 Steel 3 Stainless steel 5 Fiberglass 8 RMP (SR) 11 Other (specify)

2 Brass 4 Galvanized steel 6 Concrete tile 9 ABS 12 None used (open hole)

Screen or Perforation Openings Are: 5 Gauzed wrapped 8 Saw cut 11 None (open hole)

1 Continuous slot 3 Mill slot 6 Wire wrapped 9 Drilled holes

2 Louvered shutter 4 Key punched 7 Torch cut 10 Other (specify)

Screen-Perforation Dia in. to ft., Dia in. to ft., Dia in. to ft.

Screen-Perforated Intervals: From ft. to ft., From ft. to ft., From ft. to ft.

From ft. to ft., From ft. to ft., From ft. to ft.

Gravel Pack Intervals: From ft. to ft., From ft. to ft., From ft. to ft.

From ft. to ft., From ft. to ft., From ft. to ft.

5 GROUT MATERIAL: 1 Neat cement 2 Cement grout 3 Bentonite 4 Other

Grouted Intervals: From ft. to ft., From ft. to ft., From ft. to ft.

What is the nearest source of possible contamination: 10 Fuel storage 14 Abandoned water well

1 Septic tank 4 Cess pool 7 Sewage lagoon 11 Fertilizer storage 15 Oil well/Gas well

2 Sewer lines 5 Seepage pit 8 Feed yard 12 Insecticide storage 16 Other (specify below)

3 Lateral lines 6 Pit privy 9 Livestock pens 13 Watertight sewer lines

Direction from well How many feet ? Water Well Disinfected? Yes No

Was a chemical/bacteriological sample submitted to Department? Yes No If yes, date sample

was submitted month day year: Pump Installed? Yes No

If Yes: Pump Manufacturer's name Model No. HP Volts

Depth of Pump Intake ft. Pumps Capacity rated at gal./min.

Type of pump: 1 Submersible 2 Turbine 3 Jet 4 Centrifugal 5 Reciprocating 6 Other

6 CONTRACTOR'S OR LANDOWNER'S CERTIFICATION: This water well was (1) constructed, (2) reconstructed, or (3) plugged under my jurisdiction and was


completed on 2 month 7 day 81 year

and this record is true to the best of my knowledge and belief. Kansas Water Well Contractor's License No. 401

This Water Well Record was completed on 2 month 13 day 81 year under the business

name of by (signature) *Gary Hoby*

7 LOCATE WELL'S LOCATION WITH AN "X" IN SECTION BOX:

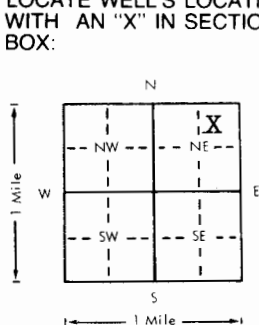

ELEVATION:

Depth(s) Groundwater Encountered 1. ft. 2. ft. 3. ft. 4. ft. (Use a second sheet if needed)

INSTRUCTIONS: Use typewriter or ball point pen, please press firmly and PRINT clearly. Please fill in blanks, underline or circle the correct answers. Send top three copies to Kansas Department of Health and Environment, Division of Environment, Water Well Contractors, Topeka, KS 66620. Send one to WATER WELL OWNER and retain one for your records.