
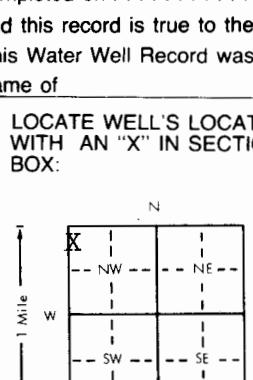


1 LOCATION OF WATER WELL		Fraction				Section Number		Township Number		Range Number			
County: Butler		NW	1/4	NW	1/4	NW	1/4	33	T 25 S	R 6 E			
Distance and direction from nearest town or city? 5-1/8 Miles NE, El Dorado						Street address of well if located within city?							
2 WATER WELL OWNER: Tulsa District Corps of Engineer						Board of Agriculture, Division of Water Resources							
RR#, St. Address, Box #: PO Box 61						Application Number:							
City, State, ZIP Code: Tulsa, Oklahoma 74121													
3 DEPTH OF COMPLETED WELL ft. Bore Hole Diameter in. to ft., and in. to ft.													
Well Water to be used as: 5 Public water supply 8 Air conditioning 11 Injection well													
1 Domestic		3 Feedlot		6 Oil field water supply		9 Dewatering		12 Other (Specify below)					
2 Irrigation		4 Industrial		7 Lawn and garden only		10 Observation well							
Well's static water level ft. below land surface measured on month day year													
Pump Test Data: Well water was ft. after hours pumping gpm													
Est. Yield gpm: Well water was ft. after hours pumping gpm													
4 TYPE OF BLANK CASING USED: 5 Wrought iron 8 Concrete tile Casing Joints: Glued Clamped													
① Steel X		3 RMP (SR)		6 Asbestos-Cement		9 Other (specify below)		Welded					
2 PVC		4 ABS		7 Fiberglass				Threaded					
Blank casing dia 8" in. to ft., Dia in. to ft., Dia in. to ft.													
Casing height above land surface in., weight lbs./ft. Wall thickness or gauge No													
TYPE OF SCREEN OR PERFORATION MATERIAL: 7 PVC 10 Asbestos-cement													
1 Steel		3 Stainless steel		5 Fiberglass		8 RMP (SR)		11 Other (specify)					
2 Brass		4 Galvanized steel		6 Concrete tile		9 ABS		12 None used (open hole)					
Screen or Perforation Openings Are: 5 Gauzed wrapped 8 Saw cut 11 None (open hole)													
1 Continuous slot		3 Mill slot		6 Wire wrapped		9 Drilled holes							
2 Louvered shutter		4 Key punched		7 Torch cut		10 Other (specify)							
Screen-Perforation Dia in. to ft., Dia in. to ft., Dia in. to ft.													
Screen-Perforated Intervals: From ft. to ft. From ft. to ft. From ft. to ft.													
Gravel Pack Intervals: From ft. to ft. From ft. to ft. From ft. to ft.													
5 GROUT MATERIAL: 1 Neat cement ② Cement grout 3 Bentonite 4 Other													
Grouted Intervals: From ft. to ft., From ft. to ft., From ft. to ft., From ft. to ft.													
What is the nearest source of possible contamination: 10 Fuel storage 14 Abandoned water well													
1 Septic tank		4 Cess pool		7 Sewage lagoon		11 Fertilizer storage		15 Oil well/Gas well					
2 Sewer lines		5 Seepage pit		8 Feed yard		12 Insecticide storage		16 Other (specify below)					
3 Lateral lines		6 Pit privy		9 Livestock pens		13 Watertight sewer lines							
Direction from well How many feet ? Water Well Disinfected? Yes No													
Was a chemical/bacteriological sample submitted to Department? Yes No If yes, date sample was submitted month day year													
If Yes: Pump Manufacturer's name Model No. HP Volts													
Depth of Pump Intake ft. Pumps Capacity rated at gal./min.													
Type of pump: 1 Submersible 2 Turbine 3 Jet 4 Centrifugal 5 Reciprocating 6 Other													
6 CONTRACTOR'S OR LANDOWNER'S CERTIFICATION: This water well was (1) constructed, (2) reconstructed, or ③ plugged under my jurisdiction and was completed on 2nd month 16th day 1981 year													
and this record is true to the best of my knowledge and belief. Kansas Water Well Contractor's License No. 401													
This Water Well Record was completed on 3rd month 2nd day 1981 year under the business name of by (signature) Mary Derby													
7 LOCATE WELL'S LOCATION WITH AN "X" IN SECTION BOX:		FROM	TO	LITHOLOGIC LOG				FROM	TO	LITHOLOGIC LOG			
													
ELEVATION:													

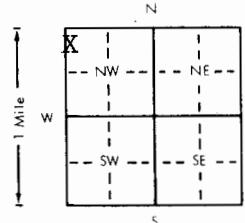

ELEVATION

Depth(s) Groundwater Encountered: _____ ft. 2 _____ ft. 3 _____ ft. 4 _____ ft. 5 _____ ft. (Use a second sheet if needed)

Depth(s) Groundwater Encountered 1. ft. 2. ft. 3. ft. 4. ft. (Use a second sheet if needed)