

1. Location of well:	County	Fraction	Section number	Township number	Range number
	Butler	SW <sub>1/4</sub> SW <sub>1/4</sub> SW <sub>1/4</sub>	11	T 25	S 7 E/W

2. Distance and direction from nearest town or city: 4 1/4 mi. N. of Rosalia, KS.

Street address of well location if in city: OF ROSALIA, KS.


3. Owner of well:

R.R. or street:


City, state, zip code: EL DORADO, KS, 67042

4. Locate with "X" in section below:

N

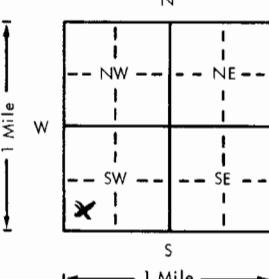

Sketch map:

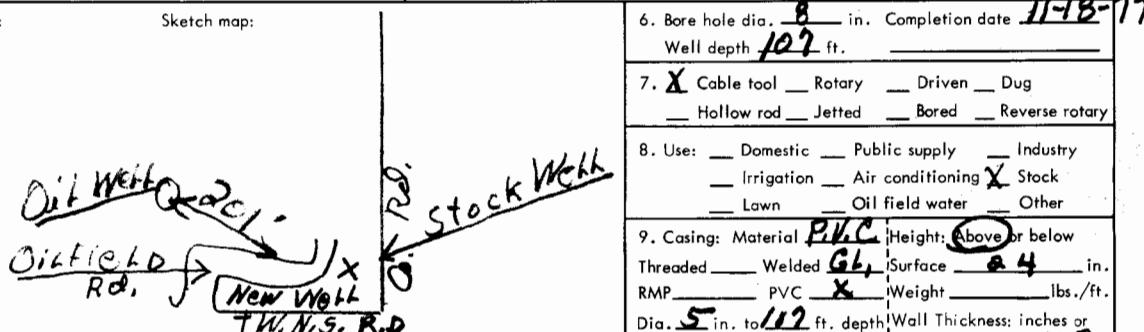

6. Bore hole dia. 8 in. Completion date 11-18-77  
Well depth 107 ft.

7.  Cable tool  Rotary  Driven  Dug  
 Hollow rod  Jetted  Bored  Reverse rotary

8. Use:  Domestic  Public supply  Industry  
 Irrigation  Air conditioning  Stock  
 Lawn  Oil field water  Other

9. Casing: Material PVC Height: Above or below  
Threaded  Welded GL Surface 84 in.  
RMP  PVC  Weight lbs./ft.  
Dia. 5 in. to 112 ft. depth Wall Thickness: inches or  
Dia. in. to ft. depth gage No. 258

10. Screen: Manufacturer's name M.P.T.

Type PVC Dia. 5  
Slot gauge 25/1000 Length 107  
Set between 97 ft. and 107 ft.  
ft. and ft.  
Gravel pack? yes Size range of material 578

11. Static water level: mo./day/yr.  
23 ft. below land surface Date 11-18-77

12. Pumping level below land surfaces:  
ft. after hrs. pumping g.p.m.  
ft. after hrs. pumping g.p.m.  
Estimated maximum yield 4 g.p.m.

13. Water sample submitted: mo./day/yr.  
Yes  No Date 11-18-77

14. Well head completion: PVC CAP  
Pitless adapter 2 1/4 inches above grade

15. Well grouted? yes  
With:  Neat cement  Bentonite  Concrete  
Depth: From 0 ft. to 10 ft.

16. Nearest source of possible contamination:  
ft. 201 Direction W Type Oil Well  
Well disinfected upon completion?  Yes  No

17. Pump:  Not installed  
Manufacturer's name  
Model number HP Volts  
Length of drop pipe ft. capacity g.p.m.  
Type:  
 Submersible  Turbine  
 Jet  Reciprocating  
 Centrifugal  Other

(Use a second sheet if needed)

18. Elevation: 19. Remarks:  
Topography:  
 Hill  
 Slope  
 Upland  
 Valley

20. Water well contractor's certification:  
This well was drilled under my jurisdiction and this report  
is true to the best of my knowledge and belief.  
PREW, 4 Const. 353  
Business name BOX 744 License No.  
Address  
Signed *Albert C. Prew* Date *11-18-77*  
Authorized representative