

1 LOCATION OF WATER WELL:

Fraction

SE  $\frac{1}{4}$  NW  $\frac{1}{4}$  SE  $\frac{1}{4}$ 

Section Number

26

Township Number

T - 25 - S

Range Number

R - 7 - E

County: ButlerDistance and direction from nearest town or city street address of well if located within city?  
1 3/4 mi. North of Rosalia, Kansas + 1/4 mi. West, north side of drive

2 WATER WELL OWNER:

Eric Knorr

RR#, St. Address, Box #:

Box 2

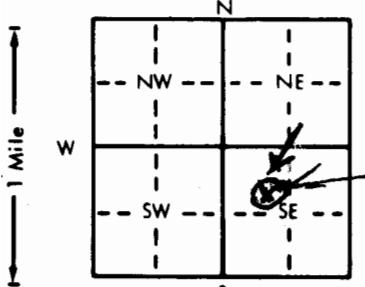
Board of Agriculture, Division of Water Resources

City, State, ZIP Code:

Rosalia, Kansas 67132

Application Number:

3 LOCATE WELL'S LOCATION WITH AN "X" IN SECTION BOX:

4 DEPTH OF COMPLETED WELL 100' ft. ELEVATION: \_\_\_\_\_Depth(s) Groundwater Encountered 51' ft. 2. \_\_\_\_\_ ft. 3. \_\_\_\_\_ ft.WELL'S STATIC WATER LEVEL 20' ft. below land surface measured on mo/day/yr 5/10/85

Pump test data: Well water was \_\_\_\_\_ ft. after \_\_\_\_\_ hours pumping \_\_\_\_\_ gpm

Est. Yield 2 1/2 gpm; Well water was \_\_\_\_\_ ft. after \_\_\_\_\_ hours pumping \_\_\_\_\_ gpmBore Hole Diameter 12' in. to 100' ft., and \_\_\_\_\_ in. to \_\_\_\_\_ ft.

WELL WATER TO BE USED AS: 5 Public water supply 8 Air conditioning 11 Injection well

① Domestic 3 Feedlot 6 Oil field water supply 9 Dewatering 12 Other (Specify below)

2 Irrigation 4 Industrial 7 Lawn and garden only 10 Observation well

Was a chemical/bacteriological sample submitted to Department? Yes \_\_\_\_\_ No \_\_\_\_\_; If yes, mo/day/yr sample was submitted

Water Well Disinfected? Yes  No

5 TYPE OF BLANK CASING USED:

1 Steel 3 RMP (SR)  
 2 PVC 4 ABS

5 Wrought iron 8 Concrete tile Casing joints: Glued  Clamped \_\_\_\_\_

6 Asbestos-Cement 9 Other (specify below) Welded \_\_\_\_\_

7 Fiberglass Threaded \_\_\_\_\_

Blank casing diameter 8' in. to 34' ft., Dia. \_\_\_\_\_ in. to \_\_\_\_\_ ft., Dia. \_\_\_\_\_ in. to \_\_\_\_\_ ft.Casing height above land surface 12' in., weight \_\_\_\_\_ lbs./ft. Wall thickness or gauge No. SDR-26

TYPE OF SCREEN OR PERFORATION MATERIAL:

1 Steel 3 Stainless steel 5 Fiberglass 8 RMP (SR)  
 2 Brass 4 Galvanized steel 6 Concrete tile 9 ABS

10 Asbestos-cement

11 Other (specify) \_\_\_\_\_

12 None used (open hole) \_\_\_\_\_

SCREEN OR PERFORATION OPENINGS ARE:

1 Continuous slot 3 Mill slot 5 Gauzed wrapped 7 PVC  
 2 Louvered shutter 4 Key punched 6 Wire wrapped 9 Drilled holes  
 3 Saw cut 10 Other (specify) \_\_\_\_\_

11 None (open hole) \_\_\_\_\_

SCREEN-PERFORATED INTERVALS: From 36' ft. to 100' ft., From \_\_\_\_\_ ft. to \_\_\_\_\_ ft., From \_\_\_\_\_ ft. to \_\_\_\_\_ ft.

From \_\_\_\_\_ ft. to \_\_\_\_\_ ft., From \_\_\_\_\_ ft. to \_\_\_\_\_ ft., From \_\_\_\_\_ ft. to \_\_\_\_\_ ft.

GRAVEL PACK INTERVALS: From 13' ft. to 100' ft., From \_\_\_\_\_ ft. to \_\_\_\_\_ ft., From \_\_\_\_\_ ft. to \_\_\_\_\_ ft.

From \_\_\_\_\_ ft. to \_\_\_\_\_ ft., From \_\_\_\_\_ ft. to \_\_\_\_\_ ft., From \_\_\_\_\_ ft. to \_\_\_\_\_ ft.

6 GROUT MATERIAL: 1 Neat cement 2 Cement grout 3 Bentonite 4 Other \_\_\_\_\_

Grout Intervals: From \_\_\_\_\_ ft. to 13' ft., From \_\_\_\_\_ ft. to \_\_\_\_\_ ft., From \_\_\_\_\_ ft. to \_\_\_\_\_ ft.

What is the nearest source of possible contamination:

1 Septic tank 4 Lateral lines 7 Pit privy  
 2 Sewer lines 5 Cess pool 8 Sewage lagoon  
 3 Watertight sewer lines 6 Seepage pit 9 Feedyard

10 Livestock pens 14 Abandoned water well

11 Fuel storage 15 Oil well/Gas well

12 Fertilizer storage 16 Other (specify below)

Direction from well?

WestHow many feet? 250'

FROM TO LITHOLOGIC LOG FROM TO LITHOLOGIC LOG

FROM	TO	LITHOLOGIC LOG	FROM	TO	LITHOLOGIC LOG
0	3	Soil			
3	7	Gravel (H.I.)			
7	26	LIMESTONE			
26	34	Shale			
34	51	LIMESTONE			
51	64	Shale			
64	69	RED BED			
69	86	LIMESTONE			
86	88	Sandy Limestone			
88	100	LIMESTONE			

7 CONTRACTOR'S OR LANDOWNER'S CERTIFICATION: This water well was (1) constructed, (2) reconstructed, or (3) plugged under my jurisdiction and was completed on (mo/day/year) May 15, 1985 and this record is true to the best of my knowledge and belief, KansasWater Well Contractor's License No. 413 This Water Well Record was completed on (mo/day/year) May 16, 1985under the business name of Tumble Weed Drilling by (signature) Thomas J. Maehle

INSTRUCTIONS: Use typewriter or ball point pen, PLEASE PRESS FIRMLY and PRINT clearly. Please fill in blanks, underline or circle the correct answers. Send top three copies to Kansas Department of Health and Environment, Division of Environment, Environmental Geology Section, Topeka, KS 66620. Send one to WATER WELL OWNER and retain one for your records.