

1 LOCATION OF WATER WELL:

Fraction

NE $\frac{1}{4}$ NE $\frac{1}{4}$ NE $\frac{1}{4}$

Section Number

30

Township Number

T 25

Range Number

R 70

County: Barton Distance and direction from nearest town or city street address of well if located within city?

6 East 3 N of Eldorado Kan

2 WATER WELL OWNER:

H. W. Jr. Fitzgerald Eldorado Kan

Board of Agriculture, Division of Water Resources

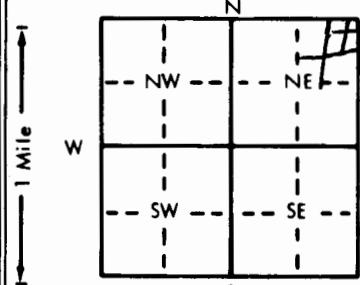
RR#, St. Address, Box #

City, State, ZIP Code

215 S Taylor 67042

Application Number:

3 LOCATE WELL'S LOCATION WITH AN "X" IN SECTION BOX:

4 DEPTH OF COMPLETED WELL: 145 ft. ELEVATION:Depth(s) Groundwater Encountered 1.95 ft. 2. ft. 3. ft.WELL'S STATIC WATER LEVEL 25 ft. below land surface measured on mo/day/yr

Pump test data: Well water was ft. after hours pumping gpm

Est. Yield 200 gpm Well water was ft. after hours pumping gpmBore Hole Diameter 8 1/2 in. to ft., and in. to ft.

WELL WATER TO BE USED AS: 5 Public water supply 8 Air conditioning 11 Injection well

1 Domestic 3 Feedlot 6 Oil field water supply 9 Dewatering 12 Other (Specify below)

2 Irrigation 4 Industrial 7 Lawn and garden only 10 Observation well

Was a chemical/bacteriological sample submitted to Department? Yes No If yes, mo/day/yr sample was submittedWater Well Disinfected? Yes No

5 TYPE OF BLANK CASING USED:

1 Steel 3 RMP (SR)
2 PVC 4 ABSBlank casing diameter 5 in. to 75 ft., Dia in. to ft., Dia in. to ft.Casing height above land surface 18 in., weight 200 lbs./ft. Wall thickness or gauge No. 2.14

TYPE OF SCREEN OR PERFORATION MATERIAL:

1 Steel 3 Stainless steel 5 Fiberglass
2 Brass 4 Galvanized steel 6 Concrete tile

7 PVC 10 Asbestos-cement

8 RMP (SR) 11 Other (specify)

9 ABS 12 None used (open hole)

8 Saw cut

11 None (open hole)

9 Drilled holes

10 Other (specify)

5 Gauzed wrapped

6 Wire wrapped

7 Torch cut

















