

1 LOCATION OF WATER WELL:

Fraction

NW 1/4 NW 1/4 NE 1/4

Section Number

16

Township Number

T 25 S

Range Number

R 8 E/W

County: BUTLER

Distance and direction from nearest town or city street address of well if located within city?

5N - 4.5E OF RDSALIA AND HWY 54

2 WATER WELL OWNER: BUCKLEY IND.

RR#, St. Address, Box #

BOX 574 - WICHITA KS 67201

Board of Agriculture, Division of Water Resources
Application Number:3 LOCATE WELL'S LOCATION WITH
AN "X" IN SECTION BOX:

4 DEPTH OF COMPLETED WELL 33 ft. ELEVATION: -

Depth(s) Groundwater Encountered 1 23 ft. 2 - ft. 3 - ft.

WELL'S STATIC WATER LEVEL 21 ft. below land surface measured on mo/day/yr

Pump test data: Well water was - ft. after - hours pumping - gpm

Est. Yield 5 gpm: Well water was - ft. after - hours pumping - gpm

Bore Hole Diameter 48 in. to 23 ft. and 10 in. to 33 ft.

WELL WATER TO BE USED AS: 5 Public water supply 8 Air conditioning 11 Injection well

1 Domestic 3 Feedlot 6 Oil field water supply 9 Dewatering 12 Other (Specify below)

2 Irrigation 4 Industrial 7 Lawn and garden only 10 Monitoring well

Was a chemical/bacteriological sample submitted to Department? Yes - No - If yes, mo/day/yr sample was submitted -

Water Well Disinfected? Yes No

5 TYPE OF BLANK CASING USED:

5 Wrought iron 8 Concrete tile CASING JOINTS: Glued Clamped -

1 Steel

3 RMP (SR)

6 Asbestos-Cement

9 Other (specify below)

Welded -

2 PVC

4 ABS

7 Fiberglass

Threaded -

Blank casing diameter 6 in. to 33 ft. Dia - in. to - ft. Dia - in. to - in. to - ft.

Casing height above land surface 24 in. weight - 160 lbs./ft. Wall thickness or gauge No. -

TYPE OF SCREEN OR PERFORATION MATERIAL:

7 PVC 10 Asbestos-cement

1 Steel

3 Stainless steel

5 Fiberglass

8 RMP (SR)

11 Other (specify) -

2 Brass

4 Galvanized steel

6 Concrete tile

9 ABS

12 None used (open hole) -

SCREEN OR PERFORATION OPENINGS ARE:

1 Continuous slot 3 Mill slot

5 Gauzed wrapped

8 Saw cut

11 None (open hole) -

2 Louvered shutter 4 Key punched

6 Wire wrapped

9 Drilled holes

SCREEN-PERFORATED INTERVALS: From 24 ft. to 33 ft. From - ft. to - ft. From - ft. to - ft.

7 Torch cut

10 Other (specify) -

GRAVEL PACK INTERVALS: From 20 ft. to 33 ft. From - ft. to - ft. From - ft. to - ft.

8 ft. to - ft. From - ft. to - ft. From - ft. to - ft.

6 GROUT MATERIAL: * 1 Neat cement 2 Cement grout 3 Bentonite 4 Other -

Grout Intervals: From 5 ft. to 5.5 ft. From - ft. to - ft. From - ft. to - ft. From - ft. to - ft.

What is the nearest source of possible contamination:

1 Septic tank 4 Lateral lines

7 Pit privy

10 Livestock pens

14 Abandoned water well

2 Sewer lines

5 Cess pool

8 Sewage lagoon

11 Fuel storage

15 Oil well/Gas well

3 Watertight sewer lines 6 Seepage pit

9 Feedyard

12 Fertilizer storage

16 Other (specify below) -

Direction from well? NE

13 Insecticide storage

SALT WATER

How many feet? 55' TO 200' FIELD

FROM TO LITHOLOGIC LOG FROM TO PLUGGING INTERVALS

UNKNOWN * HAND DUG


Z1 Z5 LIME

Z5 Z6.5 SHALE

26.5 Z9.5 LIME

Z9.5 30 SHALE LIMESTONE WALL

30 33 LIME TD. REMOVED

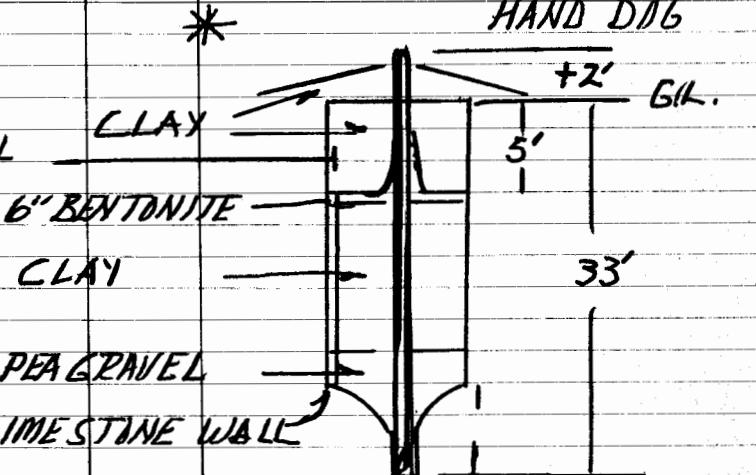

7 CONTRACTOR'S OR LANDOWNER'S CERTIFICATION: This water well was (1) constructed, (2) reconstructed, or (3) plugged under my jurisdiction and was completed on (mo/day/year) 09-06-90 and this record is true to the best of my knowledge and belief. Kansas

Water Well Contractor's License No. 479 This Water Well Record was completed on (mo/day/yr) 09-08-90

under the business name of EBBERTS DRILLING by (signature) Morgan Ebbert