


1 LOCATION OF WATER WELL: County: Sedgwick	Fraction NW ¼ SW ¼ SW ¼	Section Number 27	Township Number T 26 S	Range Number R 1	(E/W)
---	----------------------------	----------------------	---------------------------	---------------------	-------

Distance and direction from nearest town or city street address of well if located within city?

3850 North Hydraulic Avenue, Wichita, Kansas

2] WATER WELL OWNER:	Unified School District No. 259	01958012	MW-9
RR#, St. Address, Box # :	3850 North Hydraulic Avenue	Board of Agriculture, Division of Water Resources	
City, State, ZIP Code :	Wichita, Kansas	Application Number:	

3] LOCATE WELL'S LOCATION WITH AN "X" IN SECTION BOX:	4] DEPTH OF COMPLETED WELL..... 34 ft. ELEVATION: Approx. Surface 1330
---	--

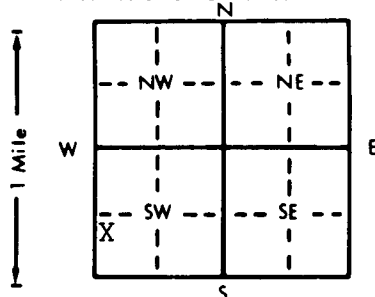

4 DEPTH OF COMPLETED WELL..... 34 ft. ELEVATION: Approx. Surface 1330
 Depth(s) Groundwater Encountered 1. ft. 2. ft. 3. ft.
 WELL'S STATIC WATER LEVEL 15 ft. below land surface measured on mo/day/yr 09/08/95
 Pump test data: Well water was ft. after hours pumping gpm
 Est. Yield N/A gpm: Well water was ft. after hours pumping gpm
 Bore Hole Diameter... 8.25 ... in. to 34 ft., and in. to ft.
 WELL WATER TO BE USED AS: 5 Public water supply 8 Air conditioning 11 Injection well
 1 Domestic 3 Feedlot 6 Oil field water supply 9 Dewatering 12 Other (Specify below)
 2 Irrigation 4 Industrial 7 Lawn and garden only 10 Monitoring well
 Was a chemical/bacteriological sample submitted to Department? Yes..... No. X.....; If yes, mo/day/yr sample was submitted
 Water Well Disinfected? Yes..... No. X.....

5] TYPE OF BLANK CASING USED:		5 Wrought iron	8 Concrete tile	CASING JOINTS: Glued	Clamped
1 Steel	3 RMP (SR)	6 Asbestos-Cement	9 Other (specify below)	Welded	
② PVC	4 ABS	7 Fiberglass		Threaded	X

Blank casing diameter 2 . . . in. to . . . 11.5 . . . ft., Dia in. to ft., Dia in. to ft.
Casing height above land surface -2 . . . in. weight lbs./ft. Wall thickness or gauge No. Schedule 40

TYPE OF SCREEN OR PERFORATION MATERIAL:			⑦ PVC	10 Asbestos-cement
1 Steel	3 Stainless steel	5 Fiberglass	8 RMP (SR)	11 Other (specify)
2 Brass	4 Galvanized steel	6 Concrete tile	9 ABS	12 None used (open hole)

SCREEN OR PERFORATION OPENINGS ARE:

1 Continuous slot	3 Mill slot	5 Gauzed wrapped	8 Saw cut	11 None (open hole)
2 Louvered shutter	4 Key punched	6 Wire wrapped	9 Drilled holes	
		7 Torch cut	10 Other (specify)	

SCREEN-PERFORATED INTERVALS:	From	11.5	ft. to	34	ft., From		ft. to		ft.
	From		ft. to		ft., From		ft. to		ft.
GRAVEL PACK INTERVALS:	From	9	ft. to	34	ft., From		ft. to		ft.
	From		ft. to		ft., From		ft. to		ft.

6 GROUT MATERIAL: 1 Neat cement 2 Cement grout 3 Bentonite 4 Other

Grout Intervals: From 0 ft. to 6 ft. From 6 ft. to 9 ft. From 9 ft. to 12 ft.

What is the nearest source of possible contamination:			
1 Septic tank	4 Lateral lines	7 Pit privy	10 Livestock pens
2 Sewer lines	5 Cess pool	8 Sewage lagoon	11 Fuel storage
3 Watertight sewer lines	6 Seepage pit	9 Feedyard	12 Fertilizer storage
			13 Insecticide storage
			14 Abandoned water well
			15 Oil well/Gas well
			16 Other (specify below)

Direction from well?			How many feet?		
FROM	TO	LITHOLOGIC LOG	FROM	TO	PLUGGING INTERVALS
0	0.5	Asphalt			
0.5	1.0	Sub-Grade			
1.0	3.0	Fill			
3.0	4.0	Olive, Clayey, Fine to Medium Sand			
4.0	8.0	Dark Brown Fat Clay			
8.0	13.0	Dark Brown Fat Clay, Trace Sand			
13.0	23.0	Olive-Brown Fat Clay, Trace Sand			
23.0	25.0	Brown, Medium to Coarse Sand			
		With Gravel			
25.0	32.0	Olive Fat Clay			
32.0	34.0	Dark Gray Shale			

7] CONTRACTOR'S OR LANDOWNER'S CERTIFICATION: This water well was (1) constructed, (2) reconstructed, or (3) plugged under my jurisdiction and was completed on (mo/day/year) 08/24/95 and this record is true to the best of my knowledge and belief. Kansas Water Well Contractor's License No. 416 This Water Well Record was completed on (mo/day/yr) 12/18/97 under the business name of Terracon Consultants, Inc. by (signature) Steve Fischer