


1 LOCATION OF WATER WELL: Fraction $\frac{1}{4}$ SE $\frac{1}{4}$ NW $\frac{1}{4}$ Section Number 35 Township Number T 26 S Range Number R 1 EW
 County: Sedgwick

Distance and direction from nearest town or city street address of well if located within city?
 4111 East 37th Street North, Wichita, Kansas

2 WATER WELL OWNER: Koch Industries, Inc. 01968501 MW-18
 RR#, St. Address, Box #: 4111 East 37th Street North Board of Agriculture, Division of Water Resources
 City, State, ZIP Code: Wichita, Kansas 67208 Application Number:

3 LOCATE WELL'S LOCATION WITH AN "X" IN SECTION BOX:

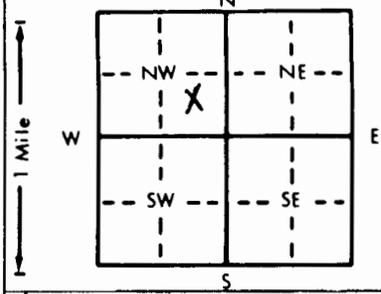

4 DEPTH OF COMPLETED WELL: 33.4 ft. ELEVATION: 1353.6
 Depth(s) Groundwater Encountered 1. 8.35 ft. 2. ft. 3. ft.
 WELL'S STATIC WATER LEVEL: 1345.25 ft. below land surface measured on mo/day/yr 02/01/96
 Pump test data: Well water was ft. after hours pumping gpm
 Est. Yield N/A gpm: Well water was ft. after hours pumping gpm
 Bore Hole Diameter: 8.25 in. to 34 ft., and in. to ft.
 WELL WATER TO BE USED AS:
 5 Public water supply 8 Air conditioning 11 Injection well
 1 Domestic 3 Feedlot 6 Oil field water supply 9 Dewatering 12 Other (Specify below)
 2 Irrigation 4 Industrial 7 Lawn and garden only 10 Monitoring well
 Was a chemical/bacteriological sample submitted to Department? Yes No X; If yes, mo/day/yr sample was submitted
 Water Well Disinfected? Yes No X

5 TYPE OF BLANK CASING USED:
 1 Steel 3 RMP (SR) 5 Wrought iron 8 Concrete tile CASING JOINTS: Glued Clamped
 2 PVC 4 ABS 6 Asbestos-Cement 9 Other (specify below) Welded
 7 Fiberglass Threaded
 Blank casing diameter 2 in. to 4 ft., Dia. in. to ft., Dia. in. to ft.
 Casing height above land surface 3 in., weight lbs./ft. Wall thickness or gauge No. Schedule 40
 TYPE OF SCREEN OR PERFORATION MATERIAL:
 1 Steel 3 Stainless steel 5 Fiberglass 8 RMP (SR) 10 Asbestos-cement
 2 Brass 4 Galvanized steel 6 Concrete tile 9 ABS 11 Other (specify)
 12 None used (open hole)
 SCREEN OR PERFORATION OPENINGS ARE:
 1 Continuous slot 3 Mill slot 5 Gauzed wrapped 8 Saw cut 11 None (open hole)
 2 Louvered shutter 4 Key punched 6 Wire wrapped 9 Drilled holes
 7 Torch cut 10 Other (specify)
 SCREEN-PERFORATED INTERVALS: From 4 ft. to 34 ft., From ft. to ft.
 From ft. to ft., From ft. to ft.
 GRAVEL PACK INTERVALS: From 3 ft. to 34 ft., From ft. to ft.
 From ft. to ft., From ft. to ft.

6 GROUT MATERIAL: 1 Neat cement 2 Cement grout 3 Bentonite 4 Other
 Grout Intervals: From 0 ft. to 2 ft., From 2 ft. to 3 ft., From ft. to ft.
 What is the nearest source of possible contamination:
 1 Septic tank 4 Lateral lines 7 Pit privy 10 Livestock pens 14 Abandoned water well
 2 Sewer lines 5 Cess pool 8 Sewage lagoon 11 Fuel storage 15 Oil well/Gas well
 3 Watertight sewer lines 6 Seepage pit 9 Feedyard 12 Fertilizer storage 16 Other (specify below)
 13 Insecticide storage Former Holding Tank
 Direction from well? Northwest How many feet? 800

FROM	TO	LITHOLOGIC LOG	FROM	TO	PLUGGING INTERVALS
0	5.4	Clay, Medium Brown, Moist			
5.4	7.2	Clay With Sand, Medium Sand, Moist			
7.2	8.5	Poorly Graded Sand, Moist-Wet			
8.5	11.6	Clay, Orangish Brown, Moist			
11.6	12.4	Sandy Clay, Medium Sand, Moist			
12.4	16.7	Clay, Moist, Black Mottling			
16.7	17.0	Poorly Grade Sand, Medium Sand, Wet			
17.0	33.5	Clay, Light Gray, Iron Oxide Stains			
33.5	34.0	Shale, Dark Gray			

7 CONTRACTOR'S OR LANDOWNER'S CERTIFICATION: This water well was 1 constructed, (2) reconstructed, or (3) plugged under my jurisdiction and was completed on (mo/day/year) 02/06/96 and this record is true to the best of my knowledge and belief. Kansas Water Well Contractor's License No. 416 This Water Well Record was completed on (mo/day/yr) 02/27/96 under the business name of Terracon Consultants, Inc. by (signature) Steve Fisher