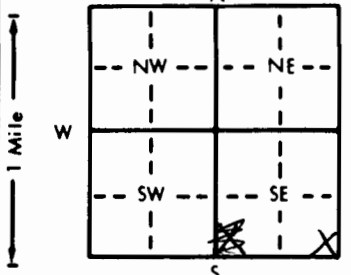


C3L

## WATER WELL RECORD Form WWC-5 KSA 82a-1212

MW-22

|   |      |   |                |                 |                    |
|---|------|---|----------------|-----------------|--------------------|
| 1 LOCATION OF WATER WELL:   |      | Fraction   | Section Number | Township Number | Range Number       |
| County: Sedgewick   |      | SE 1/4 SE 1/4 SE 1/4                                                                                           | 8              | T 26 S          | R 1 EW             |
| Distance and direction from nearest town or city street address of well if located within city?   |      |   |                |                 |                    |
| 6209 n. Broadway   |      |   |                |                 |                    |
| 2 WATER WELL OWNER:   |      | Board of Agriculture, Division of Water Resources                                                              |                |                 |                    |
| RR#, St. Address, Box #   |      | Application Number:                                                                                            |                |                 |                    |
| City, State, ZIP Code   |      | 6209 n. Broadway<br>Park City MO                                                                               |                |                 |                    |
| 3 LOCATE WELL'S LOCATION WITH AN "X" IN SECTION BOX:   |      | 4 DEPTH OF COMPLETED WELL: 42 ft. ELEVATION:                                                                   |                |                 |                    |
|   |      | Depth(s) Groundwater Encountered 1. 1.2 ft. 2. ft. 3. ft.                                                      |                |                 |                    |
|   |      | WELL'S STATIC WATER LEVEL 8.97 ft. below land surface measured on mo/day/yr 6/24/99                            |                |                 |                    |
|   |      | Pump test data: Well water was ft. after hours pumping gpm                                                     |                |                 |                    |
|   |      | Est. Yield gpm: Well water was ft. after hours pumping gpm                                                     |                |                 |                    |
|   |      | Bore Hole Diameter 8.625 in. to 42 ft. and in. to ft.                                                          |                |                 |                    |
|   |      | WELL WATER TO BE USED AS: 5 Public water supply 8 Air conditioning 11 Injection well                           |                |                 |                    |
|   |      | 1 Domestic 3 Feedlot 6 Oil field water supply 9 Dewatering 12 Other (Specify below)                            |                |                 |                    |
|   |      | 2 Irrigation 4 Industrial 7 Lawn and garden only 10 Monitoring well MW-22                                      |                |                 |                    |
|   |      | Was a chemical/bacteriological sample submitted to Department? Yes No X If yes, mo/day/yr sample was submitted |                |                 |                    |
|   |      | Water Well Disinfected? Yes No X                                                                               |                |                 |                    |
| 5 TYPE OF BLANK CASING USED:   |      | CASING JOINTS: Glued Clamped                                                                                   |                |                 |                    |
| 1 Steel 3 RMP (SR) 5 Wrought iron 8 Concrete tile   |      | Welded   |                |                 |                    |
| 2 PVC 4 ABS 6 Asbestos-Cement 9 Other (specify below)   |      | Threaded X   |                |                 |                    |
| Blank casing diameter 2 in. to 32 ft. Dia   |      | in. to ft. Dia in. to ft.                                                                                      |                |                 |                    |
| Casing height above land surface Flush in. weight 50 lbs./ft. Wall thickness or gauge No.   |      |   |                |                 |                    |
| TYPE OF SCREEN OR PERFORATION MATERIAL:   |      | 7 PVC 10 Asbestos-cement                                                                                       |                |                 |                    |
| 1 Steel 3 Stainless steel 5 Fiberglass 8 RMP (SR) 11 Other (specify)   |      |   |                |                 |                    |
| 2 Brass 4 Galvanized steel 6 Concrete tile 9 ABS 12 None used (open hole)   |      |   |                |                 |                    |
| SCREEN OR PERFORATION OPENINGS ARE:   |      | 5 Gauzed wrapped 8 Saw cut 11 None (open hole)                                                                 |                |                 |                    |
| 1 Continuous slot 3 Mill slot 6 Wire wrapped 9 Drilled holes   |      |   |                |                 |                    |
| 2 Louvered shutter 4 Key punched 7 Torch cut 10 Other (specify)   |      |   |                |                 |                    |
| SCREEN-PERFORATED INTERVALS: From 32 ft. to 42 ft.   |      | ft. From ft. to ft.                                                                                            |                |                 |                    |
| GRAVEL PACK INTERVALS: From 31 ft. to 42 ft.   |      | ft. From ft. to ft.                                                                                            |                |                 |                    |
| 6 GROUT MATERIAL:   |      | 4 Other   |                |                 |                    |
| 1 Neat cement 2 Cement grout 3 Bentonite   |      |   |                |                 |                    |
| Grout Intervals 31 ft. to 12 ft. 12 ft. to 0 ft.   |      | ft. From ft. to ft.                                                                                            |                |                 |                    |
| What is the nearest source of possible contamination:   |      | 10 Livestock pens 14 Abandoned water well                                                                      |                |                 |                    |
| 1 Septic tank 4 Lateral lines 7 Pit privy 11 Fuel storage 15 Oil well/Gas well   |      |   |                |                 |                    |
| 2 Sewer lines 5 Cess pool 8 Sewage lagoon 12 Fertilizer storage 16 Other (specify below)   |      | contaminated site                                                                                              |                |                 |                    |
| 3 Watertight sewer lines 6 Seepage pit 9 Feedyard 13 Insecticide storage   |      |   |                |                 |                    |
| Direction from well?   |      | How many feet?                                                                                                 |                |                 |                    |
| FROM   | TO   | LITHOLOGIC LOG                                                                                                 | FROM           | TO              | PLUGGING INTERVALS |
| 0   | 1    | SOIL   |                |                 |                    |
| 1   | 8    | Clay w/ some silt                                                                                              |                |                 |                    |
| 8   | 17   | silt w/ some clay                                                                                              |                |                 |                    |
| 17   | 41.5 | sand   |                |                 |                    |
| 41.5   | 42   | Shale   |                |                 |                    |
| 42   | TD   | end of bore hole                                                                                               |                |                 |                    |
| 7 CONTRACTOR'S OR LANDOWNER'S CERTIFICATION: This water well was (1) constructed, (2) reconstructed, or (3) plugged under my jurisdiction and was completed on (mo/day/year) 6/17/99 and this record is true to the best of my knowledge and belief. Kansas   |      |   |                |                 |                    |
| Water Well Contractor's License No. SBS This Water Well Record was completed on (mo/day/yr) 07/09/99   |      |   |                |                 |                    |
| under the business name of AEL by (signature) A. D. D.   |      |   |                |                 |                    |
| INSTRUCTIONS: Use typewriter or ball point pen. PLEASE PRESS FIRMLY and PRINT clearly. Please fill in blanks, underline or circle the correct answers. Send top three copies to Kansas Department of Health and Environment, Bureau of Water, Topeka, Kansas 66620-0001. Telephone: 913-296-5545. Send one to WATER WELL OWNER and retain one for your records. |      |   |                |                 |                    |