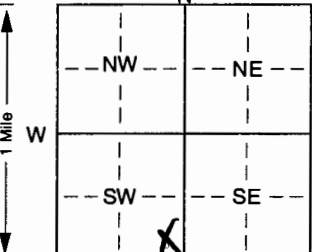


LOCATION OF WATER WELL: County: Sedgwick Fraction: SE 1/4 SE 1/4 SW 1/4 Section Number: 27 Township Number: 26 Range Number: 1 EW  
 Distance and direction from nearest town or city street address of well if located within city? 3850 N. Hydraulic  
 2 WATER WELL OWNER: USD 259  
 RR#, St. Address, Box #: 3850 N. Hydraulic  
 City, State, ZIP Code: Wichita KS 67219 Board of Agriculture, Division of Water Resources  
 Application Number: 134497  
 3 LOCATE WELL'S LOCATION WITH AN "X" IN SECTION BOX:   
 4 DEPTH OF COMPLETED WELL: 25 ft. ELEVATION: 1344.97  
 Depth(s) Groundwater Encountered: 1. 0 ft. 2. 0 ft. 3. 0 ft.  
 WELL'S STATIC WATER LEVEL: 0 ft. below land surface measured on mo/day/yr  
 Pump test data: Well water was 0 ft. after 0 hours pumping 0 gpm  
 Est. Yield 0 gpm: Well water was 0 ft. after 0 hours pumping 0 gpm  
 Bore Hole Diameter: 8.5 in. to 25 ft., and 0 in. to 0 ft.  
 WELL WATER TO BE USED AS: 5 Public water supply 8 Air conditioning 11 Injection well  
 1 Domestic 3 Feedlot 6 Oil field water supply 9 Dewatering 12 Other (Specify below)  
 2 Irrigation 4 Industrial 7 Domestic (lawn & garden) 10 Monitoring well mw-19  
 Was a chemical/bacteriological sample submitted to Department? Yes. X No. X; If yes, mo/day/yr sample was submitted  
 Water Well Disinfected? Yes X No X  
 5 TYPE OF BLANK CASING USED: 5 Wrought iron 8 Concrete tile CASING JOINTS: Glued. 0 Clamped. 0  
 1 Steel 3 RMP (SR) 6 Asbestos-Cement 9 Other (specify below) Welded 0  
2 PVC 4 ABS 7 Fiberglass Threaded Flush  
 Blank casing diameter: 2 in. to 13 ft., Dia. 0 in. to 0 ft., Dia. 0 in. to 0 ft.  
 Casing height above land surface: Flush in., weight 703 lbs./ft. Wall thickness or gauge No. Sch 40  
 TYPE OF SCREEN OR PERFORATION MATERIAL: 7 PVC 10 Asbestos-cement  
 1 Steel 3 Stainless steel 5 Fiberglass 8 RMP (SR) 11 Other (specify) 0  
 2 Brass 4 Galvanized steel 6 Concrete tile 9 ABS 12 None used (open hole)  
 SCREEN OR PERFORATION OPENINGS ARE: 5 Gauzed wrapped 8 Saw cut 11 None (open hole)  
 1 Continuous slot 3 Mill slot 6 Wire wrapped 9 Drilled holes  
 2 Louvered shutter 4 Key punched 7 Torch cut 10 Other (specify) 0 ft.  
 SCREEN-PERFORATED INTERVALS: From 13 ft. to 23 ft., From 0 ft. to 0 ft.  
 From 0 ft. to 0 ft., From 0 ft. to 0 ft.  
 GRAVEL PACK INTERVALS: From 10 ft. to 25 ft., From 0 ft. to 0 ft.  
 From 0 ft. to 0 ft., From 0 ft. to 0 ft.  
 6 GROUT MATERIAL: 1 Neat cement 2 Cement grout 3 Bentonite 4 Other 0  
 Grout Intervals: From 3 ft. to 10 ft., From 0 ft. to 0 ft., From 0 ft. to 0 ft.  
 What is the nearest source of possible contamination: 10 Livestock pens 14 Abandoned water well  
 1 Septic tank 4 Lateral lines 7 Pit privy 11 Fuel storage 15 Oil well/Gas well  
 2 Sewer lines 5 Cess pool 8 Sewage lagoon 12 Fertilizer storage 16 Other (specify below)  
 3 Watertight sewer lines 6 Seepage pit 9 Feedyard 13 Insecticide storage  
 Direction from well? How many feet?  
 FROM TO LITHOLOGIC LOG FROM TO PLUGGING INTERVALS  
0 1.9 Clay 0 0  
1.9 5 Shale, trace sand, organics 0 0  
5 14 Shale 0 0  
14 17.4 weathered shale 0 0  
17.4 25 Shale 0 0  
 7 CONTRACTOR'S OR LANDOWNER'S CERTIFICATION: This water well was (1) constructed, (2) reconstructed, or (3) plugged under my jurisdiction and was completed on (mo/day/year) 11/17/00 and this record is true to the best of my knowledge and belief. Kansas  
 Water Well Contractor's Licence No. 531 This Water Well Record was completed on (mo/day/yr) 12/18/00  
 under the business name of Geotechnical Services, Inc by (signature) Allison M. [Signature]  
 INSTRUCTIONS: Use typewriter or ball point pen. PLEASE PRESS FIRMLY and PRINT clearly. Please fill in blanks, underline or circle the correct answers. Send top three copies to Kansas Department of Health and Environment, Bureau of Water, Topeka, Kansas 66620-0001. Telephone 785-296-5524. Send one to WATER WELL OWNER and retain one for your records. Fee of \$5.00 for each constructed well.