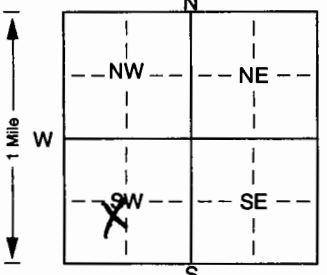


26W26Z

WATER WELL RECORD Form WWC-5 KSA 82a-1212 ID No.

1 LOCATION OF WATER WELL:		Fraction	Section Number	Township Number	Range Number
County: Sedgwick		NE 1/4 SW 1/4 SW 1/4	27	T 26 S	R 1 E
Distance and direction from nearest town or city street address of well if located within city?					
3850 N Hydraulic					
2 WATER WELL OWNER:					
USD 259					
RR#, St. Address, Box #: 3850 N Hydraulic					
City, State, ZIP Code: Wichita KS 67219					
Board of Agriculture, Division of Water Resources					
Application Number:					
3 LOCATION WELL'S LOCATION WITH					
AN "X" IN SECTION BOX:					
					
4 DEPTH OF COMPLETED WELL: 24.19 ft. ELEVATION: 1332.36 TOC					
Depth(s) Groundwater Encountered 1. 19 ft. 2. ft. 3. ft.					
WELL'S STATIC WATER LEVEL: ft. below land surface measured on mo/day/yr					
Pump test data: Well water was ft. after hours pumping gpm					
Est. Yield gpm: Well water was ft. after hours pumping gpm					
Bore Hole Diameter: 8.5 in. to 24 in. and in. to ft.					
WELL WATER TO BE USED AS:					
5 Public water supply 8 Air conditioning 11 Injection well					
1 Domestic 3 Feedlot 6 Oil field water supply 9 Dewatering 12 Other (Specify below)					
2 Irrigation 4 Industrial 7 Domestic (lawn & garden) 10 Monitoring well MW-8R					
Was a chemical/bacteriological sample submitted to Department? Yes. No. X; If yes, mo/day/yr sample was submitted					
Water Well Disinfected? Yes No X					
5 TYPE OF BLANK CASING USED:					
1 Steel 3 RMP (SR) 5 Wrought iron 8 Concrete tile CASING JOINTS: Glued. Clamped.					
2 PVC 4 ABS 6 Asbestos-Cement 9 Other (specify below) Welded					
7 Fiberglass Threaded Flush					
Blank casing diameter 2 in. to 18 ft. Dia in. to ft. Dia in. to ft.					
Casing height above land surface: Flush in. weight 703 lbs./ft. Wall thickness or gauge No. Sch 40					
TYPE OF SCREEN OR PERFORATION MATERIAL:					
1 Steel 3 Stainless steel 5 Fiberglass 8 RMP (SR) 10 Asbestos-cement					
2 Brass 4 Galvanized steel 6 Concrete tile 9 ABS 11 Other (specify)					
12 None used (open hole)					
SCREEN OR PERFORATION OPENINGS ARE:					
1 Continuous slot 3 Mill slot 5 Gauzed wrapped 8 Saw cut 11 None (open hole)					
2 Louvered shutter 4 Key punched 6 Wire wrapped 9 Drilled holes					
7 Torch cut 10 Other (specify) ft.					
SCREEN-PERFORATED INTERVALS: From 18 ft. to 23 ft. From ft. to ft.					
From ft. to ft. From ft. to ft.					
GRAVEL PACK INTERVALS: From 15 ft. to 24 ft. From ft. to ft.					
From ft. to ft. From ft. to ft.					
6 GROUT MATERIAL: 1 Neat cement 2 Cement grout 3 Bentonite 4 Other					
Grout Intervals: From 3 ft. to 15 ft. From ft. to ft. From ft. to ft.					
What is the nearest source of possible contamination:					
1 Septic tank 4 Lateral lines 7 Pit privy 10 Livestock pens 14 Abandoned water well					
2 Sewer lines 5 Cess pool 8 Sewage lagoon 11 Fuel storage 15 Oil well/Gas well					
3 Watertight sewer lines 6 Seepage pit 9 Feedyard 12 Fertilizer storage 16 Other (specify below)					
13 Insecticide storage					
Direction from well? How many feet?					
FROM	TO	LITHOLOGIC LOG	FROM	TO	PLUGGING INTERVALS
0	18.8	Clay, some sand			
18.8	20.1	Sand, trace clay			
20.1	24	Shale, weathered			
7 CONTRACTOR'S OR LANDOWNER'S CERTIFICATION: This water well was (1) constructed, (2) reconstructed, or (3) plugged under my jurisdiction and was completed on (mo/day/year) 11/17/00 and this record is true to the best of my knowledge and belief. Kansas Water Well Contractor's Licence No. 531 This Water Well Record was completed on (mo/day/yr) 12/18/00 under the business name of Geotechnical Services, Inc. by (signature) Alvin M. Smith					
INSTRUCTIONS: Use typewriter or ball point pen. PLEASE PRESS FIRMLY and PRINT clearly. Please fill in blanks, underline or circle the correct answers. Send top three copies to Kansas Department of Health and Environment, Bureau of Water, Topeka, Kansas 66620-0001. Telephone 785-296-5524. Send one to WATER WELL OWNER and retain one for your records. Fee of \$5.00 for each constructed well.					