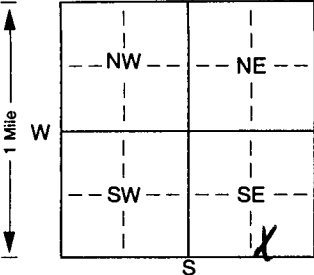


DDC-53-12

WATER WELL RECORD Form WWC-5 KSA 82a-1212 ID No.

1 LOCATION OF WATER WELL:		Fraction	Section Number	Township Number	Range Number
County: Sedgwick		SW 1/4 SE 1/4 SE 1/4	17	T 26 S	R 1 E
Distance and direction from nearest town or city street address of well if located within city? 21200 feet West Broadway on the north side of N. 53th Street, Wichita, KS					
2 WATER WELL OWNER: EPA Region #7					
RR#, St. Address, Box #: 901 N 53th Street					
City, State, ZIP Code: Kansas City, KS 66101					
Board of Agriculture, Division of Water Resources Application Number:					
3 LOCATE WELL'S LOCATION WITH AN "X" IN SECTION BOX:		4 DEPTH OF COMPLETED WELL: 48 ft. ELEVATION: 10.5 ft.			
		Depth(s) Groundwater Encountered: 1. 10.5 ft. 2. ft. 3. ft. WELL'S STATIC WATER LEVEL: 12 ft. below land surface measured on mo/day/yr 7/12/01 Pump test data: Well water was ft. after hours pumping gpm Est. Yield gpm: Well water was ft. after hours pumping gpm Bore Hole Diameter: 16.5 in. to 48 ft. and in. to ft. WELL WATER TO BE USED AS: 5 Public water supply 8 Air conditioning 11 Injection well 1 Domestic 3 Feedlot 6 Oil field water supply 9 Dewatering 12 Other (Specify below) 2 Irrigation 4 Industrial 7 Domestic (lawn & garden) 10 Monitoring well Remediation Well DDC-53-12			
Was a chemical/bacteriological sample submitted to Department? Yes. No. X; If yes, mo/day/yr sample was submitted Water Well Disinfected? Yes No X					
5 TYPE OF BLANK CASING USED: 1 Steel 3 RMP (SR) 5 Wrought iron 8 Concrete tile CASING JOINTS: Glued. Clamped. 2 PVC 4 ABS 6 Asbestos-Cement 9 Other (specify below) Welded 5 13 7 Fiberglass 5 23-36 Threaded Flush Blank casing diameter 5 in. to 13 ft. Dia. 5 in. to 23-36 ft. Dia. in. to ft. Casing height above land surface: Flush in., weight 2.77 lbs./ft. Wall thickness or gauge No. Sch 40					
TYPE OF SCREEN OR PERFORATION MATERIAL: 1 Steel 2 Stainless steel 5 Fiberglass 7 PVC 10 Asbestos-cement 2 Brass 4 Galvanized steel 6 Concrete tile 8 RMP (SR) 11 Other (specify) SCREEN OR PERFORATION OPENINGS ARE: 1 Continuous slot 3 Mill slot 5 Gauzed wrapped 8 Saw cut 11 None (open hole) 2 Louvered shutter 4 Key punched 6 Wire wrapped 9 Drilled holes SCREEN-PERFORATED INTERVALS: From 13 ft. to 23 ft. From 23 ft. to 46 ft. From 46 ft. to 48 ft. GRAVEL PACK INTERVALS: From 8 ft. to 25 ft. From 25 ft. to 33 ft. From 33 ft. to 48 ft.					
6 GROUT MATERIAL: 1 Neat cement 2 Cement grout 3 Bentonite 4 Other Grout Intervals: From 3 ft. to 8 ft. From 8 ft. to 25 ft. From 25 ft. to 27 ft. From 27 ft. to 31 ft. From 31 ft. to 33 ft. What is the nearest source of possible contamination: 1 Septic tank 4 Lateral lines 7 Pit privy 10 Livestock pens 14 Abandoned water well 2 Sewer lines 5 Cess pool 8 Sewage lagoon 11 Fuel storage 15 Oil well/Gas well 3 Watertight sewer lines 6 Seepage pit 9 Feedyard 12 Fertilizer storage 16 Other (specify below) Direction from well? Northeast How many feet? 1300 Midland Refinery					
7 CONTRACTOR'S OR LANDOWNER'S CERTIFICATION: This water well was (1) constructed (2) reconstructed, or (3) plugged under my jurisdiction and was completed on (mo/day/year) 3/30/01 and this record is true to the best of my knowledge and belief. Kansas Water Well Contractor's Licence No. 531 This Water Well Record was completed on (mo/day/yr) 9/18/01 under the business name of Geotechnical Services, Inc. by (signature) [Signature]					
INSTRUCTIONS: Use typewriter or ball point pen. PLEASE PRESS FIRMLY and PRINT clearly. Please fill in blanks, underline or circle the correct answers. Send top three copies to Kansas Department of Health and Environment, Bureau of Water, Topeka, Kansas 66620-0001. Telephone 785-296-5524. Send one to WATER WELL OWNER and retain one for your records. Fee of \$5.00 for each constructed well.					