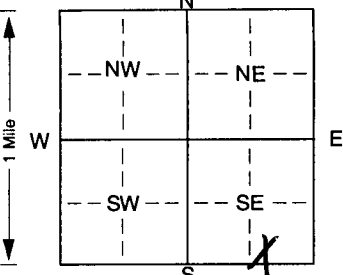


P-53-9d

WATER WELL RECORD Form WWC-5 KSA 82a-1212 ID No.

1 LOCATION OF WATER WELL:		Fraction	Section Number	Township Number	Range Number
County: <u>Sedgwick</u>		<u>SW</u> $\frac{1}{4}$ <u>SE</u> $\frac{1}{4}$ <u>SE</u> $\frac{1}{4}$	<u>17</u>	T <u>26</u> S	R <u>1</u> <u>SW</u>
Distance and direction from nearest town or city street address of well if located within city? <u>1050 feet west of Broadway on the north side of N. 53rd Street, Wichita, KS</u>					
2 WATER WELL OWNER: <u>EPA Region #7</u>					
RR#, St. Address, Box #: <u>901 N. 53rd Street</u>					
City, State, ZIP Code: <u>Kansas City, KS 66101</u>					
Board of Agriculture, Division of Water Resources Application Number:					
3 LOCATE WELL'S LOCATION WITH		4 DEPTH OF COMPLETED WELL <u>48</u> ft. ELEVATION:			
AN "X" IN SECTION BOX:		Depth(s) Groundwater Encountered <u>1</u> <u>12.5</u> ft. 2. ft. 3. ft.			
		WELL'S STATIC WATER LEVEL <u>10.5</u> ft. below land surface measured on mo/day/yr <u>6/5/01</u>			
		Pump test data: Well water was ft. after hours pumping gpm			
		Est. Yield gpm: Well water was ft. after hours pumping gpm			
		Bore Hole Diameter: <u>8.5</u> in. to ft., and in. to ft.			
		WELL WATER TO BE USED AS: 5 Public water supply 8 Air conditioning 11 Injection well			
		1 Domestic 3 Feedlot 6 Oil field water supply 9 Dewatering 12 Other (Specify below)			
		2 Irrigation 4 Industrial 7 Domestic (lawn & garden) 10 Monitoring well <u>Piezometer P-53-9d</u>			
		Was a chemical/bacteriological sample submitted to Department? Yes. No. <u>X</u> ; If yes, mo/day/yr sample was submitted			
		Water Well Disinfected? Yes No <u>X</u>			
5 TYPE OF BLANK CASING USED:					
1 Steel 3 RMP (SR) 6 Asbestos-Cement 9 Other (specify below) CASING JOINTS: Glued. Clamped.					
2 <u>PVC</u> 4 <u>ABS</u> 7 Fiberglass Welded					
Blank casing diameter in. to <u>38</u> ft., Dia in. to ft., Dia in. to ft.					
Casing height above land surface: <u>Flush</u> in., weight <u>0.703</u> lbs./ft. Wall thickness or gauge No. <u>5440</u>					
TYPE OF SCREEN OR PERFORATION MATERIAL:					
1 Steel 3 Stainless steel 5 Fiberglass 8 RMP (SR) 10 Asbestos-cement					
2 Brass 4 Galvanized steel 6 Concrete tile 9 ABS 11 Other (specify)					
SCREEN OR PERFORATION OPENINGS ARE:					
1 Continuous slot 3 <u>Mill slot</u> 5 Gauzed wrapped 8 Saw cut 11 None (open hole)					
2 Louvered shutter 4 Key punched 6 Wire wrapped 9 Drilled holes 10 Other (specify) ft.					
SCREEN-PERFORATED INTERVALS: From <u>38</u> ft. to <u>48</u> ft., From ft. to ft.					
GRAVEL PACK INTERVALS: From <u>32.5</u> ft. to <u>48</u> ft., From ft. to ft.					
6 GROUT MATERIAL: 1 Neat cement 2 Cement grout <u>29</u> 3 <u>Bentonite</u> 4 Other					
Grout Intervals: From <u>3</u> ft. to <u>11.5</u> ft., From <u>29</u> ft. to <u>32.5</u> ft., From ft. to ft.					
What is the nearest source of possible contamination:					
1 Septic tank 4 Lateral lines 7 Pit privy 10 Livestock pens 14 Abandoned water well					
2 Sewer lines 5 Cess pool 8 Sewage lagoon 11 Fuel storage 15 Oil well/Gas well					
3 Watertight sewer lines 6 Seepage pit 9 Feedyard 12 Fertilizer storage 16 Other (specify below)					
Direction from well <u>Northeast</u> How many feet? <u>1300</u>					
FROM	TO	LITHOLOGIC LOG	FROM	TO	PLUGGING INTERVALS
0	5	Sandy clay - dark brown, fine to coarse sand			
5	14	Silty sand - tan, fine to very fine sand			
14	21	Sand - medium to very coarse			
21	22	Sandy clay - tan to grey, fine sand			
22	37	Sand - medium to very coarse			
37	38.5	Sand - coarse to very coarse			
38.5	47	Sand - medium to very coarse			
47	48	Weathered shale - olive			
7 CONTRACTOR'S OR LANDOWNER'S CERTIFICATION: This water well was <u>(1) constructed</u> , (2) reconstructed, or (3) plugged under my jurisdiction and was completed on (mo/day/year) <u>8/30/01</u> and this record is true to the best of my knowledge and belief. Kansas					
Water Well Contractor's Licence No. <u>539</u> This Water Well Record was completed on (mo/day/yr) <u>9/18/01</u>					
under the business name of <u>Geotechnical Services, Inc.</u> by (signature) <u>Allen M. [Signature]</u>					
INSTRUCTIONS: Use typewriter or ball point pen. PLEASE PRESS FIRMLY and PRINT clearly. Please fill in blanks, underline or circle the correct answers. Send top three copies to Kansas Department of Health and Environment, Bureau of Water, Topeka, Kansas 66620-0001. Telephone 785-296-5524. Send one to WATER WELL OWNER and retain one for your records. Fee of \$5.00 for each constructed well.					