P-53-10S

WATER WELL RECORD Form WWC-5 KSA 82a-1212 ID No.

1 LOCATION OF WATER WELL: County: Sedgwick | Fraction: SW ¼ SE ¼ SE ¼ | Section Number: 17 | Township Number: T 26 S | Range Number: R 1 E/W

Distance and direction from nearest town or city street address of well if located within city?
~1100 feet west of Broadway and north of N. 53rd Street, Wichita, KS

2 WATER WELL OWNER: EPA Region #7
RR#, St. Address, Box # : 901 N 5th Street
City, State, ZIP Code : Kansas City, KS 66101
Board of Agriculture, Division of Water Resources Application Number:

3 LOCATE WELL'S LOCATION WITH AN "X" IN SECTION BOX:

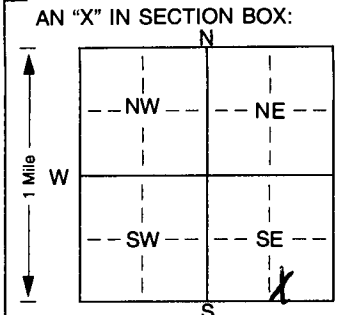

4 DEPTH OF COMPLETED WELL: 23.2 ft. ELEVATION:
Depth(s) Groundwater Encountered 1. 10.5 ft. 2. ft. 3. ft.
WELL'S STATIC WATER LEVEL 10.09 ft. below land surface measured on mo/day/yr 6/25/01
Pump test data: Well water was ft. after hours pumping gpm
Est. Yield gpm: Well water was ft. after hours pumping gpm
Bore Hole Diameter 8.5 in. to 23.2 ft., and in. to ft.
WELL WATER TO BE USED AS: 5 Public water supply 8 Air conditioning 11 Injection well
1 Domestic 3 Feedlot 6 Oil field water supply 9 Dewatering (12 Other) (Specify below)
2 Irrigation 4 Industrial 7 Domestic (lawn & garden) 10 Monitoring well Piezometer P-53-10S
Was a chemical/bacteriological sample submitted to Department? Yes No 1; If yes, mo/day/yrs sample was submitted Water Well Disinfected? Yes No X

5 TYPE OF BLANK CASING USED: 5 Wrought iron 8 Concrete tile CASING JOINTS: Glued Clamped
1 Steel 3 RMP (SR) 6 Asbestos-Cement 9 Other (specify below) Welded
(2 PVC) 4 ABS 7 Fiberglass (Threaded) Flush
Blank casing diameter 2 in. to 13.2 ft., Dia in. to ft., Dia in. to ft.
Casing height above land surface Flush in., weight 0.703 lbs./ft. Wall thickness or gauge No. Sch 40

TYPE OF SCREEN OR PERFORATION MATERIAL: (7 PVC)
1 Steel 3 Stainless steel 5 Fiberglass 8 RMP (SR) 10 Asbestos-cement
2 Brass 4 Galvanized steel 6 Concrete tile 9 ABS 11 Other (specify) 12 None used (open hole)

SCREEN OR PERFORATION OPENINGS ARE: 5 Gauzed wrapped 8 Saw cut 11 None (open hole)
1 Continuous slot (3 Mill slot) 6 Wire wrapped 9 Drilled holes
2 Louvered shutter 4 Key punched 7 Torch cut 10 Other (specify) ft.
SCREEN-PERFORATED INTERVALS: From 13.2 ft. to 23.2 ft., From ft. to ft.
From 9 ft. to 23.2 ft., From ft. to ft.
GRAVEL PACK INTERVALS: From 9 ft. to 23.2 ft., From ft. to ft.
From ft. to ft., From ft. to ft.

6 GROUT MATERIAL: 1 Neat cement 9 2 Cement grout (3 Bentonite) 4 Other
Grout Intervals: From 3 ft. to 9 ft., From ft. to ft., From ft. to ft.
What is the nearest source of possible contamination:
1 Septic tank 4 Lateral lines 7 Pit privy 10 Livestock pens 14 Abandoned water well
2 Sewer lines 5 Cess pool 8 Sewage lagoon 11 Fuel storage 15 Oil well/Gas well
3 Watertight sewer lines 6 Seepage pit 9 Feedyard 12 Fertilizer storage (16 Other (specify below)) Midland Refining
13 Insecticide storage
Direction from well? Northeast How many feet? 1300

FROM	TO	LITHOLOGIC LOG	FROM	TO	PLUGGING INTERVALS
0	5	Sandy Clay - dk brown, Fine to Coarse sand			
5	9	Clayey Sand/Silty Sand - Tan to grey, F-VF Sand			
9	11.5	Sand - Fine to Coarse grained			
11.5	14	Sand - Medium to Very coarse			
14	22	Sand - Fine grained			
22	23.2	Sand - Med. to Very Coarse, some Fine			

7 CONTRACTOR'S OR LANDOWNER'S CERTIFICATION: This water well was (1) constructed, (2) reconstructed, or (3) plugged under my jurisdiction and was completed on (mo/day/year) 8/30/01 and this record is true to the best of my knowledge and belief. Kansas Water Well Contractor's Licence No. 531 This Water Well Record was completed on (mo/day/yr) 9/18/01 under the business name of Geotechnical Services, Inc. by (signature)

INSTRUCTIONS: Use typewriter or ball point pen. *PLEASE PRESS FIRMLY* and *PRINT* clearly. Please fill in blanks, underline or circle the correct answers. Send top three copies to Kansas Department of Health and Environment, Bureau of Water, Topeka, Kansas 66620-0001. Telephone 785-296-5524. Send one to WATER WELL OWNER and retain one for your records. Fee of $5.00 for each constructed well.