

MW-B

1 LOCATION OF WATER WELL:	Fraction	Section Number	Township Number	Range Number
County: <u>Sedwick</u>	<u>NE 1/4 SE 1/4 SW 1/4</u>	<u>29</u>	<u>26S</u>	<u>R1E</u>

Distance and direction from nearest town or city street address of well if located within city?

130' S.W. of S.W. corner Maint. Bldg2 WATER WELL OWNER: S.W. BellRR#, St. Address, Box #: 3917 N. Arkansas


Board of Agriculture, Division of Water Resources

City, State, ZIP Code: Wichita, KS 67204

Application Number:

3 MARK WELL'S LOCATION WITH AN "X" IN SECTION BOX:

N

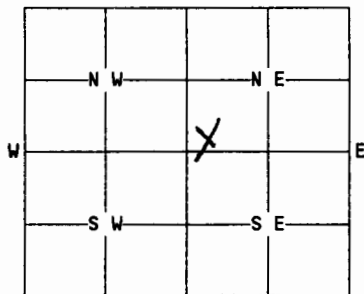

S

4 DEPTH OF WELL.....22'.....ft.

WELL'S STATIC WATER LEVEL.....ft.

WELL WAS USED AS:

- 1 Domestic
- 2 Irrigation
- 3 Feedlot
- 4 Industrial

- 5 Public Water Supply
- 6 Oil Field Water Supply
- 7 Lawn and Garden Only
- 8 Air Conditioning

9 Dewatering

10 Monitoring Well

11 Injection Well

12 Other.....

Was a chemical/bacteriological sample submitted to Department? Yes....No....  
If yes, mo/day/yr sample was submitted.....Water Well Disinfected: Yes..... No. X..

5 TYPE OF BLANK CASING USED:

1 Steel

3 RMP (SR)

5 Wrought

7 Fiberglass

9 Other (specify below)

2 PVC

4 ABS

6 Asbestos-Cement

8 Concrete Tile

Blank casing diameter.....2.....in. Was casing pulled? Yes. X.... No..... If yes, how much...22'....  
Casing height above or below land surface.....2.....in.6 GROUT PLUG MATERIAL: 1 Neat cement 2 Cement grout 3 Bentonite 4 Other.....Grout Plug Intervals: From 1.0 ft. to 22.0 ft., From.....ft. to .....ft., From..... to .....ft.

What is the nearest source of possible contamination:

1 Septic tank

6 Seepage pit

11 Fuel storage

16 Other (specify below)

2 Sewer lines

7 Pit privy

12 Fertilizer storage

3 Watertight sewer lines

8 Sewage lagoon

13 Insecticide storage

4 Lateral lines

9 Feedyard

14 Abandoned water well

5 Cess Pool

10 Livestock pens

15 Oil well/Gas well

Direction from well? .....

How many feet? .....

FROM	TO	PLUGGING MATERIALS
<u>1.0</u>	<u>22.0</u>	<u>Bentonite Chips</u>

7 CONTRACTOR'S OR LANDOWNER'S CERTIFICATION: This water well was plugged under my jurisdiction and was completed on (mo/day/year)....12-18-01.... and this record is true to the best of my knowledge and belief. Kansas Water Well Contractor's License No. ....1054A.... This Water Well Record was completed on (mo/day/year)....1-28-02.... under the business name of ....Thorndyke Contract Drilling, L.L.C..... by (signature) ....Andrew S. Thorndyke.....

INSTRUCTIONS: Use typewriter or ball point pen. Please press firmly and print clearly. Please fill in blanks, underline or circle the correct answers. Send top three copies to Kansas Department of Health and Environment, Bureau of Water, Topeka, Kansas 66620-0001. Telephone: 785/296-3565. Send one to Water Well Owner and retain one for your records.