

1 LOCATION OF WATER WELL:		Fraction			Section Number		Township Number		Range Number	
County:	Sedgwick	NW	$\frac{1}{4}$	NW	$\frac{1}{4}$	NW	$\frac{1}{4}$	19	T 26 S	R 1 E


Distance and direction from nearest town or city street address of well if located within city?
2435 W. 53rd N. Wichita, Ks

2	WATER WELL OWNER:	James T. Ross
	RR#, St. Address, Box #	: 825 E. 2nd
	City, State, ZIP Code	: Wichita, Ks 67202

Board of Agriculture, Division of Water Resources
Application Number:

3	LOCATE WELL'S LOCATON WITH AN "X" IN SECTION BOX:
---	---

4 DEPTH OF COMPLETED WELL 20 ft. ELEVATION:

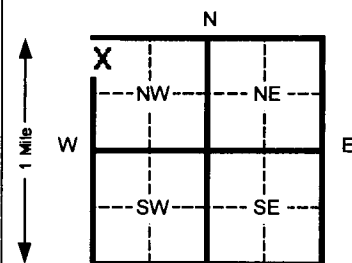

Depth(s) Groundwater Encountered NA ft. 2 _____ ft. 3 _____ Ft. _____

WELL'S STATIC WATER LEVEL NA ft. below land surface measured on mo/day/yr NA

Pump test data: Well water was _____ Ft. after _____ hours pumping _____ Gpm

Est. Yield _____ Gpm: Well water was _____ Ft. after _____ Hours pumping _____ Gpm

Bore Hole Diameter 8.625 In. to 10 ft. and _____ in. to _____ Ft.

WELL WATER TO BE USED AS:

5 Public water supply	8 Air conditioning	11 Injection well		
1 Domestic	3 Feed lot	6 Oil field water supply	9 Dewatering	12 Other (Specify below)
2 Irrigation	4 Industrial	7 Lawn and garden (domestic)	10 <u>Monitoring well</u>	<u>MW-20</u>

Was a chemical/bacteriological sample submitted to Department? Yes _____ No X If yes, mo/day/yr sample was Submitted _____

Water Well Disinfected? Yes _____ No X

5 TYPE OF BLANK CASING USED:

5 Wrought Iron	8 Concrete tile	CASING JOINTS: Glued _____ Clamped _____	
6 Asbestos-Cement	9 Other (specify below)	Welded _____	
7 Fiberglass		Threaded _____	X

Blank casing diameter	2	in. to	10	ft. Dia		in. to		ft. Dia
Casing height above land surface	FLUSH	in., weight	SCH 40		Lbs./ft.	Wall thickness or gauge No.		

TYPE OF SCREEN OR PERFORATION MATERIAL:

1 Steel	3 Stainless steel	5 Fiberglass	8 RMP (SR)	11 Other (specify) _____
2 Brass	4 Galvanized steel	6 Concrete tile	9 ABS	12 None used (open hole)

SCREEN OR PERFORATION OPENINGS ARE:			
1 Continuous slot	3 <input type="text" value="Mill slot"/>	5 Gauzed wrapped	8 Saw cut
2 Louvered shutter	4 Key punched	6 Wire wrapped	9 Drilled holes
		7 Torch cut	10 Other (specify)
			11 None (open hole)

SCREEN-PERFORATED INTERVALS:	From	10	ft. to	20	ft. From		ft. to		ft.
	From		ft. to		ft. From		ft. to		ft.
SAND PACK INTERVALS:	From	8	ft. to	20	ft. From		ft. to		ft.
	From		ft. to		ft. From		ft. to		ft.

6	GROUT MATERIAL:		1 Neat cement	2 Cement grout	3 Bentonite	4 Other					
Grout Intervals	From	3	0	ft. to	2	2	ft. to	8	ft. From	ft. to	ft. to

What is the nearest source of possible contamination:

1 Septic tank	4 Lateral lines	7 Pit privy	11 Fuel storage	15 Oil well/ Gas well
2 Sewer lines	5 Cess pool	8 Sewage lagoon	12 Fertilizer storage	16 Other (specify below)
3 Watertight sewer lines	6 Seepage pit	9 Feedyard	13 Insecticide storage	Contaminated Site

Direction from well?

How many feet?

[illegible]

7 CONTRACTOR'S OR LANDOWNER'S CERTIFICATION: This water well was (x) constructed, (2) reconstructed, or (3) plugged under my jurisdiction and was
Completed on (mo/day/yr) **07/11/02** And this record is true to the best of my knowledge and belief. Kansas

Water Well Contractor's License No. 585 This Water Well Record was completed on (mo/day/yr) 08/11/02
under the business name of Associated Environmental, Inc. By (signature) Darin R Duncan

INSTRUCTIONS: Please fill in blanks and circle the correct answers. Send three copies to Kansas Department of Health and Environment, Bureau of Water, Topeka, Kansas 66620-0001. Telephone: 913-298-5545. Send one to WATER WELL OWNER and retain one for your records.