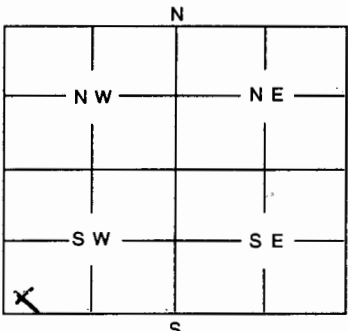


| 1 LOCATION OF WATER WELL: County: <u>SEDGWICK</u> | Fraction <u>SW 1/4 SW 1/4 SW 1/4</u> | Section Number <u>16</u> | Township Number <u>26-S</u> | Range Number <u>1-E</u> | | | | | | | | | | | | | | | | | | | | | | | | |
|---|--|---|-----------------------------|-------------------------|---------------|-----------------------|--------------------|--------------------------|--------------------------|---|-----------------------|----------------------------|---|-----------------|------------------------|----------------|-----------------|------------|-------------------------|--|-------------|-------------------|----------------------|--|--|--|--|--|
| Distance and direction from nearest town or city street address of well if located within city? <u>57th & Broadway N. Park City KS NW 1/4</u> | | | | | | | | | | | | | | | | | | | | | | | | | | | | |
| 2 WATER WELL OWNER: <u>Coastal Refining & Marketing Kansas REF Division</u> RR #, St. Address, Box #: <u>1835 N. Topska</u> City, State, ZIP Code : <u>El Dorado, KS 67042</u> | | | | | | | | | | | | | | | | | | | | | | | | | | | | |
| Board of Agriculture, Division of Water Resources Application Number: _____ | | | | | | | | | | | | | | | | | | | | | | | | | | | | |
| 3 MARK WELL'S LOCATION WITH AN "X" IN SECTION BOX: <div style="text-align: center;">  </div> | 4 DEPTH OF WELL <u>27</u> ft. WELL'S STATIC WATER LEVEL _____ ft. WELL WAS USED AS: <table style="width:100%;"> <tr> <td>1 Domestic</td> <td>5 Public Water Supply</td> <td>9 Dewatering</td> </tr> <tr> <td>2 Irrigation</td> <td>6 Oil Field Water Supply</td> <td><input checked="" type="radio"/> 10 Monitoring Well</td> </tr> <tr> <td>3 Feedlot</td> <td>7 Domestic (Lawn & Garden)</td> <td>11 Injection Well</td> </tr> <tr> <td>4 Industrial</td> <td>8 Air Conditioning</td> <td>12 Other _____</td> </tr> </table> Was a chemical / bacteriological sample submitted to Department? Yes _____ No <u>—</u> If yes, mo/day/yr sample was submitted _____ Water Well Disinfected: Yes _____ No <u>—</u> | | | | 1 Domestic | 
| 5 TYPE OF BLANK CASING USED: <table style="width:100%;"> <tr> <td>1 Steel</td> <td>3 RMP (SR)</td> <td>5 Wrought</td> <td>7 Fiberglass</td> <td>9 Other (Specify below)</td> </tr> <tr> <td><input checked="" type="radio"/> 2 PVC</td> <td>4 ABS</td> <td>6 Asbestos-Cement</td> <td>8 Concrete Tile</td> <td></td> </tr> </table> Blank casing diameter <u>4</u> in. Was casing pulled? Yes <input checked="" type="checkbox"/> No _____ If yes, how much <u>5'</u> Casing height above or below land surface <u>0</u> in. | | | | | 1 Steel | 3 RMP (SR) | 5 Wrought | 7 Fiberglass | 9 Other (Specify below) | <input checked="" type="radio"/> 2 PVC | 4 ABS | 6 Asbestos-Cement | 8 Concrete Tile | | | | | | | | | | | | | | | |
| 6 GROUT PLUG MATERIAL: 1 Neat cement 2 Cement grout <input checked="" type="radio"/> 3 Bentonite 4 Other <u>Rock & Gravel</u> Grout Plug Intervals: From _____ ft. to _____ ft., From <u>27</u> ft. to <u>1</u> ft., From <u>1</u> ft. to <u>0</u> ft. What is the nearest source of possible contamination: <table style="width:100%;"> <tr> <td>1 Septic tank</td> <td>6 Seepage pit</td> <td>11 Fuel storage</td> <td>16 Other (specify below)</td> </tr> <tr> <td>2 Sewer lines</td> <td>7 Pit privy</td> <td>12 Fertilizer storage</td> <td></td> </tr> <tr> <td><input checked="" type="radio"/> 3 Watertight sewer lines</td> <td>8 Sewage lagoon</td> <td>13 Insecticide storage</td> <td></td> </tr> <tr> <td>4 Lateral lines</td> <td>9 Feedyard</td> <td>14 Abandoned water well</td> <td></td> </tr> <tr> <td>5 Cess Pool</td> <td>10 Livestock pens</td> <td>15 Oil well/Gas well</td> <td></td> </tr> </table> Direction from well? <u>WEST</u> How many feet? <u>30'</u> | | | | | 1 Septic tank | 6 Seepage pit | 11 Fuel storage | 16 Other (specify below) | 2 Sewer lines | 7 Pit privy | 12 Fertilizer storage | 
| <table border="1" style="width:100%; border-collapse: collapse;"> <thead> <tr> <th style="width:10%;">FROM</th> <th style="width:10%;">TO</th> <th style="width:80%;">PLUGGING MATERIALS</th> </tr> </thead> <tbody> <tr> <td>27</td> <td>1</td> <td>Bentonite chips</td> </tr> <tr> <td>1</td> <td>0</td> <td>Rock & Gravel</td> </tr> <tr><td> </td><td> </td><td> </td></tr> <tr><td> </td><td> </td><td> </td></tr> <tr><td> </td><td> </td><td> </td></tr> <tr><td> </td><td> </td><td> </td></tr> <tr><td> </td><td> </td><td> </td></tr> </tbody> </table> | | | | | FROM | TO | PLUGGING MATERIALS | 27 | 1 | Bentonite chips | 1 | 0 | Rock & Gravel | | | | | | | | | | | | | | | |
| 7 CONTRACTOR'S OR LANDOWNER'S CERTIFICATION: This water well was plugged under my jurisdiction and was completed on (mo/day/year) <u>4-15-02</u> and this record is true to the best of my knowledge and belief. Kansas Water Well Contractor's License No. <u>575</u> This Water Well Record was completed on (mo/day/year) <u>4-25-02</u> under the business name of <u>FUNKER DRILLING SERVICE INC.</u> by (signature) <u>[Signature]</u> | | | | | | | | | | | | | | | | | | | | | | | | | | | | |
| INSTRUCTIONS: Use typewriter or ball point pen. Please press firmly and print clearly. Please fill in blanks, underline or circle the correct answers. Send top three copies to Kansas Department of Health and Environment, Bureau of Water, Topeka, Kansas 66620-0001. Telephone: 785/296-3565. Send one to Water Well Owner and retain one for your records. | | | | | | | | | | | | | | | | | | | | | | | | | | | | |