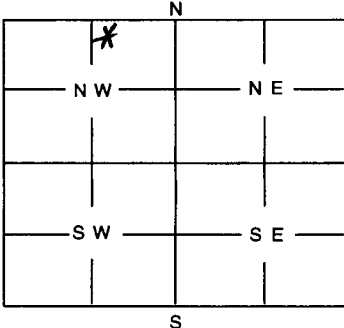


1	LOCATION OF WATER WELL:	Fraction	Section Number	Township Number	Range Number
County:	<u>SEDGWICK</u>	<u>NW 1/4 NE 1/4 NW 1/4</u>	<u>16</u>	<u>26 S</u>	<u>1 E</u>

Distance and direction from nearest town or city street address of well if located within city?

1 MILE WEST OF INTERSECTION: BROADWAY AND 61ST NORTH

2	WATER WELL OWNER:	<u>CITY OF PARK CITY</u>	<u>CITY WELL No. 5</u>
	RR #, St. Address, Box #:	<u>6110. NORTH HYDRAULIC</u>	Board of Agriculture, Division of Water Resources
	City, State, ZIP Code :	<u>PARK CITY, Kansas 67219</u>	Application Number:

3	MARK WELL'S LOCATION WITH AN "X" IN SECTION BOX:	4	DEPTH OF WELL <u>47</u> ft												
			WELL'S STATIC WATER LEVEL <u>21.50</u> ft.												
			WELL WAS USED AS:												
			<table border="0"> <tr> <td>1 Domestic</td> <td><u>5</u> Public Water Supply</td> <td>9 Dewatering</td> </tr> <tr> <td>2 Irrigation</td> <td>6 Oil Field Water Supply</td> <td>10 Monitoring Well</td> </tr> <tr> <td>3 Feedlot</td> <td>7 Domestic (Lawn & Garden)</td> <td>11 Injection Well</td> </tr> <tr> <td>4 Industrial</td> <td>8 Air Conditioning</td> <td>12 Other</td> </tr>
			Was a chemical / bacteriological sample submitted to Department? Yes No <u>X</u>												
			If yes, mo/day/yr sample was submitted												
			Water Well Disinfected: Yes <u>X</u> No												

5	TYPE OF BLANK CASING USED:
	<u>1</u> Steel 3 RMP (SR) 5 Wrought 7 Fiberglass 9 Other (Specify below) 2 PVC 4 ABS 6 Asbestos-Cement 8 Concrete Tile
	Blank casing diameter <u>12</u> in. Was casing pulled? Yes <u>X</u> No If yes, how much <u>3 FEET</u>
	Casing height above or below land surface <u>36</u> in.

6	GROUT PLUG MATERIAL:	1 Neat cement	<u>2</u> Cement grout	3 Bentonite	<u>4</u> Other <u>CHLORINATED SAND</u>
	GROUT PLUG INTERVALS:	<u>4</u> From <u>47</u> ft. to <u>21.50</u> ft.,	<u>2</u> From <u>21.50</u> ft. to <u>0</u> ft.,	From to ft.	
	What is the nearest source of possible contamination:				
	1 Septic tank 6 Seepage pit 11 Fuel storage 16 Other (specify below) 2 Sewer lines 7 Pit privy 12 Fertilizer storage <u>ENVIRONMENTAL</u> 3 Watertight sewer lines 8 Sewage lagoon 13 Insecticide storage <u>CONTAMINATION</u> 4 Lateral lines 9 Feedyard 14 Abandoned water well 5 Cess Pool 10 Livestock pens 15 Oil well/Gas well				
	Direction from well? <u>NORTH</u> How many feet? <u>1000. APPROX.</u>				

FROM	TO	PLUGGING MATERIALS
<u>0</u>	<u>21.50</u>	<u>CEMENT GROUT</u>
<u>21.50</u>	<u>47.</u>	<u>CHLORINATED SAND</u>

CITY WELL No. 5

7	CONTRACTOR'S OR LANDOWNER'S CERTIFICATION: This water well was plugged under my jurisdiction and was completed on (mo/day/year) <u>April 28, 2003</u> and this record is true to the best of my knowledge and belief. Kansas Water Well Contractor's License No. <u>581</u> This Water Well Record was completed on (mo/day/year) <u>April 30, 2003</u> under the business name of <u>LAYNE WESTERN</u>
	by (signature) <u>[Signature]</u>

INSTRUCTIONS: Use typewriter or ball point pen. Please press firmly and print clearly. Please fill in blanks, underline or circle the correct answers. Send top three copies to Kansas Department of Health and Environment, Bureau of Water, Topeka, Kansas 66620-0001. Telephone: 785/296-3565. Send one to Water Well Owner and retain one for your records.