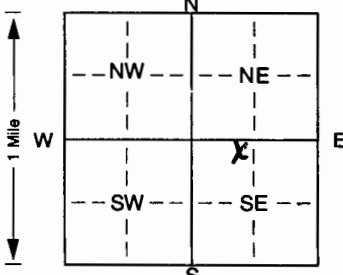


1 LOCATION OF WATER WELL: Fraction NE 1/4 NW 1/4 SE 1/4 Section Number 17 Township Number T 26 S Range Number R 1 E  
 County: Sedgwick

Distance and direction from nearest town or city street address of well if located within city? Wichita, KS Kansas Parcel # 22400' North of 53rd St North near intersection of 53rd/Broadway Wood Recycling

2 WATER WELL OWNER: Donald and Ramona Hayes MW-10  
 RR#, St. Address, Box #: 370 W. 53rd St North Board of Agriculture, Division of Water Resources  
 City, State, ZIP Code: Wichita, KS Application Number:

3 LOCATE WELL'S LOCATION WITH AN "X" IN SECTION BOX:  4 DEPTH OF COMPLETED WELL: 28.5 ft. ELEVATION: ..... ft.  
 Depth(s) Groundwater Encountered 1. 16 ft. 2. 15.96 ft. 3. .... ft.  
 WELL'S STATIC WATER LEVEL 15.96 ft. below land surface measured on mo/day/yr 8/1/03  
 Pump test data: Well water was ..... ft. after ..... hours pumping ..... gpm  
 Est. Yield ..... gpm; Well water was ..... ft. after ..... hours pumping ..... gpm  
 Bore Hole Diameter: 8 1/4 in. to 30 in. to ..... ft. and ..... in. to ..... ft.  
 WELL WATER TO BE USED AS: 5 Public water supply 8 Air conditioning 11 Injection well  
 1 Domestic 3 Feedlot 6 Oil field water supply 9 Sewatering 12 Other (Specify below)  
 2 Irrigation 4 Industrial 7 Domestic (lawn & garden) 10 Monitoring well  
 Was a chemical/bacteriological sample submitted to Department? Yes. .... No. ....; If yes, mo/day/yr sample was submitted  
 Water Well Disinfected? Yes X No X

5 TYPE OF BLANK CASING USED: 5 Wrought iron 8 Concrete tile CASING JOINTS: Glued. .... Clamped. ....  
 1 Steel 3 RMP (SR) 6 Asbestos-Cement 9 Other (specify below) Welded .....  
2 PVC 4 ABS 7 Fiberglass Threaded. X  
 Blank casing diameter 2.0 in. to 8.0 ft. Dia ..... in. to ..... ft. Dia ..... in. to ..... ft.  
 Casing height above land surface 2.5 in., weight ..... lbs./ft. Wall thickness or gauge No. SCH 40  
 TYPE OF SCREEN OR PERFORATION MATERIAL: 7 PVC 10 Asbestos-cement  
 1 Steel 3 Stainless steel 5 Fiberglass 8 RMP (SR) 11 Other (specify) .....  
 2 Brass 4 Galvanized steel 6 Concrete tile 9 ABS 12 None used (open hole)  
 SCREEN OR PERFORATION OPENINGS ARE: 5 Gauzed wrapped 8 Saw cut 11 None (open hole)  
 1 Continuous slot 3 Mill slot 6 Wire wrapped 9 Drilled holes  
 2 Louvered shutter 4 Key punched 7 Torch cut 10 Other (specify) ..... ft.  
 SCREEN-PERFORATED INTERVALS: From 8.5 ft. to 28.5 ft. From ..... ft. to ..... ft.  
 From ..... ft. to ..... ft. From ..... ft. to ..... ft.  
 GRAVEL PACK INTERVALS: From 6.0 ft. to 28.5 ft. From ..... ft. to ..... ft.  
 From ..... ft. to ..... ft. From ..... ft. to ..... ft.

6 GROUT MATERIAL: 1 Neat cement 2 Cement grout 3 Bentonite 4 Other .....  
 Grout Intervals: From 0 ft. to 6.0 ft., From ..... ft. to ..... ft., From ..... ft. to ..... ft.  
 What is the nearest source of possible contamination:  
 1 Septic tank 4 Lateral lines 7 Pit privy 10 Livestock pens 14 Abandoned water well  
 2 Sewer lines 5 Cess pool 8 Sewage lagoon 11 Fuel storage 15 Oil well/Gas well  
 3 Watertight sewer lines 6 Seepage pit 9 Feedyard 12 Fertilizer storage 16 Other (specify below)  
 13 Insecticide storage .....  
 Direction from well? ..... How many feet? .....

FROM	TO	LITHOLOGIC LOG	FROM	TO	PLUGGING INTERVALS
0	0.5	Topsoil			
0.5	3.0	Silty-Clay			
3.0	6.5	Sandy-Clay			
6.5	9.5	Silty Clay w/sand			
9.5	19.5	Sand, Well graded			
19.5	30	Sand, Coarse, poorly graded			

7 CONTRACTOR'S OR LANDOWNER'S CERTIFICATION: This water well was (1) constructed, (2) reconstructed, or (3) plugged under my jurisdiction and was completed on (mo/day/year) 7/31/03 and this record is true to the best of my knowledge and belief. Kansas Water Well Contractor's Licence No. 614 This Water Well Record was completed on (mo/day/yr) 8/1/03 under the business name of Maxim Technologies, Inc. by (signature) William Stafford