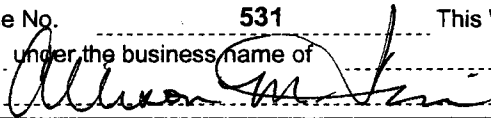


## WATER WELL PLUGGING RECORD

Form WWC-5P

KSA 82a-1212

ID No.

1 LOCATION OF WATER WELL:	Fraction <b>SW 1/4 NW 1/4 NW 1/4</b>	Section Number <b>34</b>	Township Number <b>26</b>	Range Number <b>01 E</b>																																
Distance and direction from nearest town or city street address of well if located within city? <b>3600 N. Hydraulic (SE corner of Plant Warehouse)</b>																																				
2 WATER WELL OWNER: RR#, St. Address, Box # City, State, ZIP Code :		<b>Coleman Company</b> <b>3600 N. Hydraulic</b> <b>Wichita, KS 67219</b>  Board of Agriculture, Division of Water Resources Application Number:																																		
3 MARK WELL'S LOCATION WITH AN "X" IN SECTION BOX:	4 DEPTH OF WELL <b>25.69</b> ft. WELL'S STATIC WATER LEVEL <b>~21</b> ft.  WELL WAS USED AS: <table style="width:100%; border: none;"> <tr> <td>1 Domestic</td> <td>5 Public Water Supply</td> <td>9 Dewatering</td> </tr> <tr> <td>2 Irrigation</td> <td>6 Oil Field Water Supply</td> <td><u>10 Monitoring Well</u></td> </tr> <tr> <td>3 Feedlot</td> <td>7 Lawn and Garden (domestic)</td> <td>11 Injection Well</td> </tr> <tr> <td>4 Industrial</td> <td>8 Air Conditioning</td> <td>12 Other</td> </tr> </table> Was a chemical/bacteriological sample submitted to Department? Yes _____ No <u>X</u> If yes, mo/day/yr sample was submitted _____ Water Well Disinfected: Yes _____ No <u>X</u>				1 Domestic	5 Public Water Supply	9 Dewatering	2 Irrigation	6 Oil Field Water Supply	<u>10 Monitoring Well</u>	3 Feedlot	7 Lawn and Garden (domestic)	11 Injection Well	4 Industrial	8 Air Conditioning	12 Other																				
1 Domestic	5 Public Water Supply	9 Dewatering																																		
2 Irrigation	6 Oil Field Water Supply	<u>10 Monitoring Well</u>																																		
3 Feedlot	7 Lawn and Garden (domestic)	11 Injection Well																																		
4 Industrial	8 Air Conditioning	12 Other																																		
5 TYPE OF BLANK CASING USED: <table style="width:100%; border: none;"> <tr> <td>1 Steel</td> <td>3 RMP (SR)</td> <td>5 Wrought</td> <td>7 Fiberglass</td> <td>9 Other (specify below)</td> </tr> <tr> <td><u>2 PVC</u></td> <td>4 ABC</td> <td>6 Asbestos-Cement</td> <td>8 Concrete Tile</td> <td></td> </tr> </table> Blank casing diameter <b>2</b> in. Was casing pulled? Yes _____ No <u>X</u> If yes, how much _____ Casing height above or below land surface <b>180</b> in. <b>Casing cut ~15 feet below surface by backhoe</b>					1 Steel	3 RMP (SR)	5 Wrought	7 Fiberglass	9 Other (specify below)	<u>2 PVC</u>	4 ABC	6 Asbestos-Cement	8 Concrete Tile																							
1 Steel	3 RMP (SR)	5 Wrought	7 Fiberglass	9 Other (specify below)																																
<u>2 PVC</u>	4 ABC	6 Asbestos-Cement	8 Concrete Tile																																	
6 GROUT PLUG MATERIAL: <u>1 Neat cement</u> 2 Cement grout 3 Bentonite 4 Other _____ Grout Plug Intervals From <b>0</b> ft. to <b>25.69</b> ft. From _____ ft. to _____ ft. From _____ ft. to _____ ft. What is the nearest source of possible contamination: <table style="width:100%; border: none;"> <tr> <td>1 Septic tank</td> <td>6 Seepage pit</td> <td>11 Fuel storage</td> <td>16 Other (specify below)</td> </tr> <tr> <td>2 Sewer lines</td> <td>7 Pit privy</td> <td>12 Fertilizer storage</td> <td></td> </tr> <tr> <td>3 Watertight sewer lines</td> <td>8 Sewage lagoon</td> <td>13 Insecticide storage</td> <td></td> </tr> <tr> <td>4 Lateral lines</td> <td>9 Feedyard</td> <td>14 Abandoned water well</td> <td></td> </tr> <tr> <td>5 Cess Pool</td> <td>10 Livestock pens</td> <td>15 Oil well/ Gas well</td> <td></td> </tr> </table> Direction from well? _____ How many feet? _____					1 Septic tank	6 Seepage pit	11 Fuel storage	16 Other (specify below)	2 Sewer lines	7 Pit privy	12 Fertilizer storage		3 Watertight sewer lines	8 Sewage lagoon	13 Insecticide storage		4 Lateral lines	9 Feedyard	14 Abandoned water well		5 Cess Pool	10 Livestock pens	15 Oil well/ Gas well													
1 Septic tank	6 Seepage pit	11 Fuel storage	16 Other (specify below)																																	
2 Sewer lines	7 Pit privy	12 Fertilizer storage																																		
3 Watertight sewer lines	8 Sewage lagoon	13 Insecticide storage																																		
4 Lateral lines	9 Feedyard	14 Abandoned water well																																		
5 Cess Pool	10 Livestock pens	15 Oil well/ Gas well																																		
<table border="1" style="width:100%; border-collapse: collapse;"> <thead> <tr> <th style="width:10%;">FROM</th> <th style="width:10%;">TO</th> <th style="width:10%;">CODE</th> <th style="width:70%;">PLUGGING MATERIALS</th> </tr> </thead> <tbody> <tr> <td><b>0</b></td> <td><b>25.69</b></td> <td></td> <td><b>Neat Cement (slurry)</b></td> </tr> <tr><td> </td><td> </td><td> </td><td> </td></tr> <tr><td> </td><td> </td><td> </td><td> </td></tr> <tr><td> </td><td> </td><td> </td><td> </td></tr> <tr><td> </td><td> </td><td> </td><td> </td></tr> <tr><td> </td><td> </td><td> </td><td> </td></tr> <tr><td> </td><td> </td><td> </td><td> </td></tr> </tbody> </table>				FROM	TO	CODE	PLUGGING MATERIALS	<b>0</b>	<b>25.69</b>		<b>Neat Cement (slurry)</b>																									<p>Large area east of well was being excavated. Slurry cement was poured down the well and allowed to settle overnight before the casing was excavated out. Well originally constructed ~10 years ago.</p>
FROM	TO	CODE	PLUGGING MATERIALS																																	
<b>0</b>	<b>25.69</b>		<b>Neat Cement (slurry)</b>																																	
7 CONTRACTOR'S OR LANDOWNER'S CERTIFICATION: This water well was plugged under my jurisdiction and was completed on (mo/day/yr) <b>8-8-03</b> and this record is true to the best of my knowledge and belief. Kansas Water Well Contractor's License No. <b>531</b> This Water Well Record was completed on (mo/day/yr) <b>8-12-03</b> under the business name of <b>Geotechnical Services, Inc.</b> by (signature) 																																				
INSTRUCTIONS: Please fill in blanks and circle the correct answers. Send three copies to Kansas Department of Health and Environment, Bureau of Water, 1000 S W Jackson St., Ste. 420, Topeka, Kansas 66620-0001. Telephone: 785-296-3565. Send one to Water Well Owner and retain one for your records.																																				