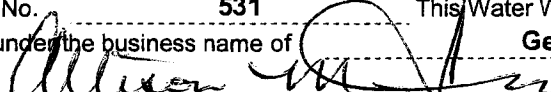


WATER WELL PLUGGING RECORD

Form WWC-5P

KSA 82a-1212

ID No.

1 LOCATION OF WATER WELL:		Fraction	Section Number	Township Number	Range Number								
County: Sedgwick		SW 1/4 NE 1/4 NW 1/4	36	26	01 E								
Distance and direction from nearest town or city street address of well if located within city? 5252 E. 36th St. North, Wichita													
2 WATER WELL OWNER:		Boeing Company											
RR#, St. Address, Box #		PO Box 7730											
City, State, ZIP Code :		Wichita KS 67227-7730											
3 MARK WELL'S LOCATION WITH AN "X" IN SECTION BOX:		Board of Agriculture, Division of Water Resources Application Number:											
<div style="text-align: center;">N</div> <table border="1" style="margin: auto; border-collapse: collapse;"><tr><td style="width: 50px; height: 50px; text-align: center;">N</td><td style="width: 50px; height: 50px; text-align: center;">NE</td></tr><tr><td style="width: 50px; height: 50px; text-align: center;">X</td><td style="width: 50px; height: 50px;"></td></tr><tr><td style="width: 50px; height: 50px;"></td><td style="width: 50px; height: 50px;"></td></tr><tr><td style="width: 50px; height: 50px; text-align: center;">SW</td><td style="width: 50px; height: 50px; text-align: center;">SE</td></tr></table> <div style="text-align: center;">S</div> <div style="display: flex; justify-content: space-between; width: 100px; margin: 0 auto;">WE</div>		N	NE	X				SW	SE	4 DEPTH OF WELL	28	ft.	
		N	NE										
		X											
SW	SE												
WELL'S STATIC WATER LEVEL		10.83	ft.										
WELL WAS USED AS:													
1 Domestic		5 Public Water Supply		9 Dewatering									
2 Irrigation		6 Oil Field Water Supply		10 Monitoring Well									
3 Feedlot		7 Lawn and Garden (domestic)		11 Injection Well									
4 Industrial		8 Air Conditioning		12 Other									
Was a chemical/bacteriological sample submitted to Department?		Yes		No X									
If yes, mo/day/yr sample was submitted													
Water Well Disinfected:		Yes		No X									
5 TYPE OF BLANK CASING USED:													
1 Steel 3 RMP (SR) 5 Wrought 7 Fiberglass 9 Other (specify below)													
2 PVC 4 ABC 6 Asbestos-Cement 8 Concrete Tile													
Blank casing diameter 2 in. Was casing pulled? Yes X No If yes, how much													
Casing height above or below land surface 240 in. Overdrilled 20 feet													
6 GROUT PLUG MATERIAL: 1 Neat cement 2 Cement grout 3 Bentonite 4 Other													
Grout Plug Intervals From 1 ft. to 28 ft. From ft. to ft. From ft. to ft.													
What is the nearest source of possible contamination:													
1 Septic tank 6 Seepage pit 11 Fuel storage 16 Other (specify below)													
2 Sewer lines 7 Pit privy 12 Fertilizer storage													
3 Watertight sewer lines 8 Sewage lagoon 13 Insecticide storage													
4 Lateral lines 9 Feedyard 14 Abandoned water well													
5 Cess Pool 10 Livestock pens 15 Oil well/ Gas well													
Direction from well? How many feet?													
FROM	TO	CODE	PLUGGING MATERIALS										
0	1		Soil										
1	28		Bentonite										
7 CONTRACTOR'S OR LANDOWNER'S CERTIFICATION: This water well was plugged under my jurisdiction and was completed on (mo/day/yr) 8-7-03 and this record is true to the best of my knowledge and belief. Kansas Water Well Contractor's License No. 531 This Water Well Record was completed on (mo/day/yr) 8-12-03 under the business name of Geotechnical Services, Inc. by (signature) 													
INSTRUCTIONS: Please fill in blanks and circle the correct answers. Send three copies to Kansas Department of Health and Environment, Bureau of Water, 1000 S W Jackson St., Ste. 420, Topeka, Kansas 66620-0001. Telephone: 785-296-3565. Send one to Water Well Owner and retain one for your records.													