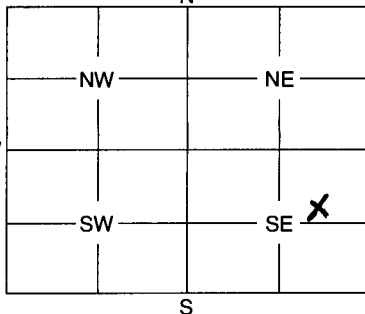


1	LOCATION OF WATER WELL:	Fraction	Section	Number	Township	Number	Range	Number																					
	County: SEDGWICK	SW 1/4 NE 1/4 SE 1/4		19		T26S	R1E	E/W																					
Distance and direction from nearest town or city street address of well if located within city? northwest corner of basement - 4835 N. Sullivan																													
2	WATER WELL OWNER:		Barbara Hagan 4835 N. Sullivan Wichita KS 67204																										
RR #, St. Address, Box #: City, State, ZIP Code :			Board of Agriculture, Division of Water Resources Application Number: Unknown																										
3	MARK WELL'S LOCATION WITH AN "X" IN SECTION BOX:		4	DEPTH OF WELL 24 ft.																									
		WELL'S STATIC WATER LEVEL 11 ft.																											
		WELL WAS USED AS:																											
		<input checked="" type="checkbox"/> 1 Domestic      5 Public Water Supply      9 Dewatering 2 Irrigation      6 Oil Field Water Supply      10 Monitoring Well 3 Feedlot      7 Domestic (Lawn & Garden)      11 Injection Well 4 Industrial      8 Air Conditioning      12 Other																											
		Was a chemical / bacteriological sample submitted to Department? Yes No <input checked="" type="checkbox"/> If yes, mo/day/yr sample was submitted																											
Water Well Disinfected: Yes <input checked="" type="checkbox"/> No																													
5	TYPE OF BLANK CASING USED:																												
<input checked="" type="radio"/> 1 Steel      3 RMP (SR)      5 Wrought      7 Fiberglass      9 Other (Specify below) 2 PVC      4 ABS      6 Asbestos-Cement      8 Concrete Tile																													
Blank casing diameter 1 1/4 in. Was casing pulled? Yes No If yes, how much Casing height above or below land surface 0 in.																													
6	GROUT PLUG MATERIAL: 1 Neat cement 2 Cement grout 3 Bentonite 4 Other																												
Grout Plug Intervals: From 24 ft. to 3 ft., From 3 ft. to 0 ft., From to																													
What is the nearest source of possible contamination:																													
1 Septic tank      6 Seepage pit      11 Fuel storage      16 Other (specify below) 2 Sewer lines      7 Pit privy      12 Fertilizer storage      SUMO PUMP 3 Watertight sewer lines      8 Sewage lagoon      13 Insecticide storage 4 Lateral lines      9 Feedyard      14 Abandoned water well 5 Cess pool      10 Livestock pens      15 Oil well/Gas well																													
Direction from well? South How many feet? 8 ft																													
<table border="1"><thead><tr><th>FROM</th><th>TO</th><th>PLUGGING MATERIALS</th></tr></thead><tbody><tr><td>3</td><td>0</td><td>Cement</td></tr><tr><td>24</td><td>3</td><td>Bentonite / bleach</td></tr><tr><td> </td><td> </td><td> </td></tr><tr><td> </td><td> </td><td> </td></tr><tr><td> </td><td> </td><td> </td></tr><tr><td> </td><td> </td><td> </td></tr></tbody></table>									FROM	TO	PLUGGING MATERIALS	3	0	Cement	24	3	Bentonite / bleach												
FROM	TO	PLUGGING MATERIALS																											
3	0	Cement																											
24	3	Bentonite / bleach																											
7	CONTRACTOR'S OF LANDOWNER'S CERTIFICATION: This water well was plugged under my jurisdiction and was completed on (mo/day/year) 12/11/03 and this record is true to the best of my knowledge and belief. Kansas Water Well Contractor's License No. 628 This Water Well Record was completed on (mo/day/year) 12/11/03 under the business name of J. Montoya & Sons by (signature) J. Montoya																												
INSTRUCTIONS: Use typewriter or ball point pen. Please press firmly and print clearly. Please fill in blanks, underline or circle the correct answers. Send top three copies to Kansas Department of Health and Environment, Bureau of Water, Geology Section, 1000 SW Jackson St., Ste. 420, Topeka, Kansas 66612-1367. Telephone: 785/296-5522. Send one to Water Well Owner and retain one for your records.																													