

1	LOCATION OF WATER WELL: County: Sedgwick	Fraction NE ¼ NE ¼ SW ¼	Section Number 8	Township Number T 26 S	Range Number R 1 E/W
---	--	-----------------------------------	----------------------------	----------------------------------	--------------------------------


Distance and direction from nearest town or city street address of well if located within city?

500 W. 61st St. North, Park City

2 WATER WELL OWNER: El Paso Corporation
 RR#, St. Address, Box # : 2 North Nevada Ave.
 City, State, ZIP Code : Colorado Springs, CO 80903

Board of Agriculture, Division of Water Resources
 Application Number:

3 LOCATE WELL'S LOCATION
WITH AN "X" IN SECTION BOX:

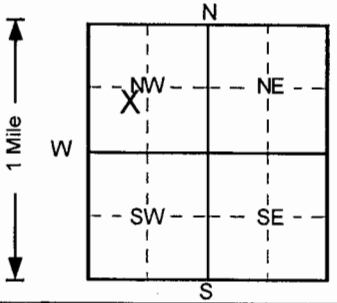

4) DEPTH OF COMPLETED WELL 30 ft. ELEVATION: 0

Depth(s) Groundwater Encountered 1. ft. 2. ft. 3. ft.

WELL'S STATIC WATER LEVEL ... 18' ... ft. below land surface measured on mo/day/yr 9/21/2004

Pump test data: Well water was ... NA ... ft. after hours pumping gpm

Est. Yield ... NA ... gpm: Well water was ft. after hours pumping gpm

Bore Hole Diameter ... 8 ... in. to ... 30 ... ft., and, in. to ft.

WELL WATER TO BE USED AS:

1 Domestic	3 Feedlot	6 Oil field water supply	9 Dewatering	11 Injection well
2 Irrigation	4 Industrial	7 Lawn and garden only	10 Monitoring well	12 Other (Specify below)

Air sparge

Was a chemical/bacteriological sample submitted to Department? Yes.....No✓.....; If yes, mo/day/yr sample was submitted

Water Well Disinfected? Yes No ✓

5	TYPE OF BLANK CASING USED:
---	----------------------------

1 Steel 3 RMP (SR) 6 Asbestos-Cement 9 Other (specify below) Welded

2 PVC 4 ABS 7 Fiberglass Threaded. ☒

Blank casing diameter 1 in. to 27.5 ft. Dia in. to ft. Dia in. to ft.
Casing height above land surface 0 in. weight lbs./ft. Wall thickness or gauge No. Sch. 40

TYPE OF SCREEN OR PERFORATION MATERIAL

1 Steel	3 Stainless steel	5 Fiberglass	8 RMP (SR)	11 Other (specify)
2 Brass	4 Galvanized steel	6 Concrete tile	9 ABS	12 None used (open hole)

SCREEN OR PERFORATION OPENINGS ARE:

1 Continuous slot **3** Mill slot 6 Wire wrapped 9 Drilled holes
2 Louvered shutter 4 Key punched 7 Torch cut 10 Other (specify)

SCREEN-PERFORATED INTERVALS: From 27.5 ft to 30 ft, From _____ ft to _____ ft.

GRAVEL PACK INTERVALS: From 25.5 ft to 30 ft From _____ ft to _____ ft

From ft. to ft. From ft. to ft.

6 GROUT MATERIAL: 1 Neat cement 2 Cement grout 3 Bentonite 4 Other

Grout Intervals: From 3 ft. to 14 ft., From 14 ft. to 25.5 ft., From ft. to ft.

What is the apparent source of possible contamination? 10. Linetankage 14. Abandoned water well

What is the nearest source or possible contamination:

1 Septic tank	4 Lateral lines	7 Pit privy	10 Livestock pens	14 Abandoned water well
2 Sewer lines	5 Cess pool	8 Sewage lagoon	11 Fuel storage	15 Oil well/Gas well
3 Watertight sewer lines	6 Seepage pit	9 Feedyard	12 Fertilizer storage	16 Other (specify below)
			13 Insecticide storage	Abandoned pipeline

Direction from well?	East	How many feet?	100
----------------------	-------------	----------------	------------

[illegible]

7. CONTRACTOR'S OR LANDOWNER'S CERTIFICATION: This water well was (1) constructed, (2) reconstructed, or (3) plugged under my jurisdiction and was completed on (mo/day/year) 9/21/2004 and this record is true to the best of my knowledge and belief.
Kansas Water Well Contractor's License No. 527 This Water Well Record was completed on (mo/day/yr) 10/7/04
under the business name of GeoCore, Inc. by (signature) Dale Kelle