WATER WELL RECORD Form WWC-5 KSA 82a-1212 ID No. _____

1 LOCATION OF WATER, WELL: County: **SEDGWICK** | Fraction: **SE** ¼ **SW** ¼ **SW** ¼ | Section Number: **12** | Township Number: T **26S** S | Range Number: R **1E** E/W

Distance and direction from nearest town or city street address of well if located within city?
452 CREEK TRAIL; KECHI

WATER WELL OWNER: **GEORGE PORTER**
RR#, St. Address, Box # : **452 CREEK TRAIL**
City, State, ZIP Code : **KECHI, KS**
Board of Agriculture, Division of Water Resources
Application Number:

3 LOCATE WELL'S LOCATON WITH AN "X" IN SECTION BOX:

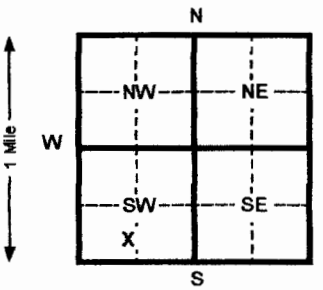

4 DEPTH OF COMPLETED WELL **138** ft. ELEVATION:
Depth(s) Groundwater Encountered 1 **32** ft. 2 _____ ft. 3 _____ ft.
WELL'S STATIC WATER LEVEL **32** ft. below land surface measured on mo/day/yr **11/30/04**
Pump test data: Well water was _____ ft. after _____ hours pumping _____ gpm
Est. Yield _____ gpm: Well water was _____ ft. after _____ hours pumping _____ gpm
Bore Hole Diameter **10** in. to **138** ft. and _____ in. to _____ ft.
WELL WATER TO BE USED AS: 5 Public water supply 8 Air conditioning 11 Injection well
1 Domestic 3 Feed lot 6 Oil field water supply 9 Dewatering 12 Other (Specify below)
2 Irrigation 4 Industrial (Lawn and garden (domestic)) 10 Monitoring well _____
Was a chemical/bacteriological sample submitted to Department? Yes _____ No **X** If yes, mo/day/yr sample was submitted
Water Well Disinfected? Yes **X** No

OFFICE USE ONLY

5 TYPE OF BLANK CASING USED: 5 Wrought iron 8 Concrete tile CASING JOINTS: Glued **X** Clamped _____
1 Steel 3 RMP (SR) 6 Asbestos-Cement 9 Other (specify below) Welded _____
(2 PVC) 4 ABS 7 Fiberglass _____ Threaded _____
Blank casing diameter **5** in. to **138** ft., Dia _____ in. to _____ ft., Dia _____ in. to _____ ft.
Casing height above land surface **16** in., weight **160** lbs./ft. Wall thickness or gauge No. **26**
TYPE OF SCREEN OR PERFORATION MATERIAL: (7 PVC) 10 Asbestos-cement
1 Steel 3 Stainless steel 5 Fiberglass 8 RMP (SR) 11 Other (specify) _____
2 Brass 4 Galvanized steel 6 Concrete tile 9 ABS 12 None used (open hole)
SCREEN OR PERFORATION OPENINGS ARE: 5 Gauzed wrapped 8 Saw cut 11 None (open hole)
1 Continuous slot (3 Mill slot) 6 Wire wrapped 9 Drilled holes
2 Louvered shutter 4 Key punched 7 Torch cut 10 Other (specify) _____
SCREEN-PERFORATED INTERVALS: From **58** ft. to **138** ft. From _____ ft. to _____ ft.
From _____ ft. to _____ ft. From _____ ft. to _____ ft.
GRAVEL PACK INTERVALS: From **24** ft. to **138** ft. From _____ ft. to _____ ft.
From _____ ft. to _____ ft. From _____ ft. to _____ ft.

6 GROUT MATERIAL: 1 Neat cement 2 Cement grout (3 Bentonite) 4 Other _____
Grout Intervals From **4** ft. to **24** ft. From _____ ft. to _____ ft. From _____ ft. to _____ ft.
What is the nearest source of possible contamination:
1 Septic tank 4 Lateral lines 7 Pit privy 10 Livestock pens 14 Abandoned water well
2 Sewer lines 5 Cess pool 8 Sewage lagoon 11 Fuel storage 15 Oil well/ Gas well
(3 Watertight sewer lines) 6 Seepage pit 9 Feedyard 12 Fertilizer storage 16 Other (specify below)
13 Insecticide storage _____
Direction from well? **WEST'H** How many feet? **33**

FROM	TO	CODE	LITHOLOGIC LOG	FROM	TO	PLUGGING INTERVALS
0	2		TOPSOIL			
2	8		TAN CLAY			
8	19		FINE SILTY SAND			
19	21		GREY CLAY			
21	65		BLUE SHALE			
65	138		BLUE SHALE/LIMESTONE			

7 CONTRACTOR'S OR LANDOWNER'S CERTIFICATION: This water well was (1) constructed, (2) reconstructed, or (3) plugged under my jurisdiction and was completed on (mo/day/yr) **11/30/04** and this record is true to the best of my knowledge and belief. Kansas Water Well Contractor's License No. **611** This Water Well Record was completed on (mo/day/yr) **12/21/04**
under the business name of **CHASE DRILLING** by (signature) R. Chase

INSTRUCTIONS:. *Please fill in blanks and circle the correct answers. Send three copies to Kansas Department of Health and Environment, Bureau of Water, 1000 S W Jackson St., Ste. 420, Topeka, Kansas 66612-1367. Telephone: 913-296-5545. Send one to WATER WELL OWNER and retain one for your records.*

T R SEC

Form provided by Forms-On-A-Disk, Inc. - Dallas, Texas - (214) 340-9429