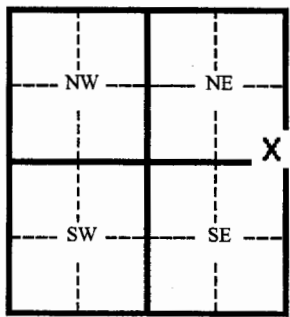
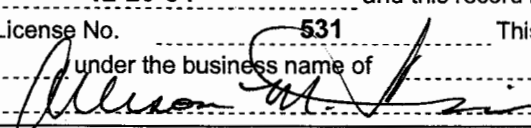


WATER WELL PLUGGING RECORD

Form WWC-5P

KSA 82a-1212

ID No.

1 LOCATION OF WATER WELL: County: Sedgwick	Fraction SE 1/4 SE 1/4 NE 1/4	Section Number 17	Township Number 26	Range Number 01 East																																				
Distance and direction from nearest town or city street address of well if located within city? 5855 N. Broadway	
2 WATER WELL OWNER: RR#, St. Address, Box # City, State, ZIP Code :		Koch Industries 5855 N. Broadway Wichita, KS 67204																																						
3 MARK WELL'S LOCATION WITH AN "X" IN SECTION BOX: <div style="text-align: center;">N  W E S</div>		4 DEPTH OF WELL 17.56 ft. WELL'S STATIC WATER LEVEL 13.76 ft. WELL WAS USED AS: <table style="width:100%;"><tr><td>1 Domestic</td><td>5 Public Water Supply</td><td>9 Dewatering</td></tr><tr><td>2 Irrigation</td><td>6 Oil Field Water Supply</td><td>10 Monitoring Well</td></tr><tr><td>3 Feedlot</td><td>7 Lawn and Garden (domestic)</td><td>11 Injection Well</td></tr><tr><td>4 Industrial</td><td>8 Air Conditioning</td><td>12 Other</td></tr></table> Was a chemical/bacteriological sample submitted to Department? Yes _____ No X If yes, mo/day/yr sample was submitted _____ Water Well Disinfected: Yes _____ No X			1 Domestic	5 Public Water Supply	9 Dewatering	2 Irrigation	6 Oil Field Water Supply	10 Monitoring Well	3 Feedlot	7 Lawn and Garden (domestic)	11 Injection Well	4 Industrial	8 Air Conditioning	12 Other																								
1 Domestic	5 Public Water Supply	9 Dewatering																																						
2 Irrigation	6 Oil Field Water Supply	10 Monitoring Well																																						
3 Feedlot	7 Lawn and Garden (domestic)	11 Injection Well																																						
4 Industrial	8 Air Conditioning	12 Other																																						
5 TYPE OF BLANK CASING USED: 1 Steel <input type="checkbox"/> 3 RMP (SR) <input type="checkbox"/> 5 Wrought <input type="checkbox"/> 7 Fiberglass <input type="checkbox"/> 9 Other (specify below) _____ 2 PVC <input checked="" type="checkbox"/> 4 ABC <input type="checkbox"/> 6 Asbestos-Cement <input type="checkbox"/> 8 Concrete Tile <input type="checkbox"/> Blank casing diameter 2 in. Was casing pulled? Yes _____ No X If yes, how much _____ Casing height above or below land surface 0.00 in. Overdrilled to 17.56 feet below ground surface	
6 GROUT PLUG MATERIAL: 1 Neat cement <input type="checkbox"/> 2 Cement grout <input checked="" type="checkbox"/> 3 Bentonite <input type="checkbox"/> 4 Other _____ Grout Plug Intervals From 0 ft. to 17.56 ft. From _____ ft. to _____ ft. From _____ ft. to _____ ft. What is the nearest source of possible contamination: <table style="width:100%;"><tr><td>1 Septic tank</td><td>6 Seepage pit</td><td>11 Fuel storage</td><td>16 Other (specify below) _____</td></tr><tr><td>2 Sewer lines</td><td>7 Pit privy</td><td>12 Fertilizer storage</td><td></td></tr><tr><td>3 Watertight sewer lines</td><td>8 Sewage lagoon</td><td>13 Insecticide storage</td><td></td></tr><tr><td>4 Lateral lines</td><td>9 Feedyard</td><td>14 Abandoned water well</td><td></td></tr><tr><td>5 Cess Pool</td><td>10 Livestock pens</td><td>15 Oil well/ Gas well</td><td></td></tr></table> Direction from well? _____ How many feet? _____					1 Septic tank	6 Seepage pit	11 Fuel storage	16 Other (specify below) _____	2 Sewer lines	7 Pit privy	12 Fertilizer storage		3 Watertight sewer lines	8 Sewage lagoon	13 Insecticide storage		4 Lateral lines	9 Feedyard	14 Abandoned water well		5 Cess Pool	10 Livestock pens	15 Oil well/ Gas well																	
1 Septic tank	6 Seepage pit	11 Fuel storage	16 Other (specify below) _____																																					
2 Sewer lines	7 Pit privy	12 Fertilizer storage																																						
3 Watertight sewer lines	8 Sewage lagoon	13 Insecticide storage																																						
4 Lateral lines	9 Feedyard	14 Abandoned water well																																						
5 Cess Pool	10 Livestock pens	15 Oil well/ Gas well																																						
<table border="1" style="width:100%; border-collapse: collapse;"> <thead> <tr> <th style="width:10%;">FROM</th> <th style="width:10%;">TO</th> <th style="width:10%;">CODE</th> <th style="width:70%;">PLUGGING MATERIALS</th> </tr> </thead> <tbody> <tr> <td>0</td> <td>17.56</td> <td></td> <td>Concrete</td> </tr> <tr><td> </td><td> </td><td> </td><td> </td></tr> <tr><td> </td><td> </td><td> </td><td> </td></tr> <tr><td> </td><td> </td><td> </td><td> </td></tr> <tr><td> </td><td> </td><td> </td><td> </td></tr> <tr><td> </td><td> </td><td> </td><td> </td></tr> <tr><td> </td><td> </td><td> </td><td> </td></tr> <tr><td> </td><td> </td><td> </td><td> </td></tr> </tbody> </table>					FROM	TO	CODE	PLUGGING MATERIALS	0	17.56		Concrete																												
FROM	TO	CODE	PLUGGING MATERIALS																																					
0	17.56		Concrete																																					
7 CONTRACTOR'S OR LANDOWNER'S CERTIFICATION: This water well was plugged under my jurisdiction and was completed on (mo/day/yr) 12-20-04 and this record is true to the best of my knowledge and belief. Kansas Water Well Contractor's License No. 531 This Water Well Record was completed on (mo/day/yr) 1-19-05 under the business name of Geotechnical Services, Inc. by (signature) 	
INSTRUCTIONS: Please fill in blanks and circle the correct answers. Send three copies to Kansas Department of Health and Environment, Bureau of Water, 1000 S W Jackson St., Ste. 420, Topeka, Kansas 66620-0001. Telephone: 785-296-3565. Send one to Water Well Owner and retain one for your records.	