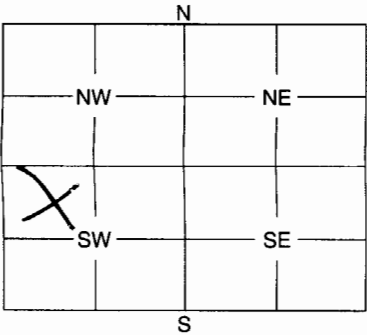


1	LOCATION OF WATER WELL:	Fraction	Section	Number	Township	Number	Range	Number																											
	County: <u>Sedgewick</u>	<u>SW</u> $\frac{1}{4}$ $\frac{1}{4}$	<u>4</u>		<u>26S</u>		<u>1E</u>	E/W																											
Distance and direction from nearest town or city street address of well if located within city? <u>Northeast of city</u>																																			
2	WATER WELL OWNER: <u>Yolonda Owens</u>																																		
RR #, St. Address, Box #:			Board of Agriculture, Division of Water Resources																																
City, State, ZIP Code: <u>1733 E. Norman</u>			Application Number: _____																																
3	MARK WELL'S LOCATION WITH AN "X" IN SECTION BOX:		4	DEPTH OF WELL <u>30</u> ft.																															
			WELL'S STATIC WATER LEVEL <u>15</u> ft.																																
			WELL WAS USED AS:																																
			<table style="width:100%; border: none;"> <tr> <td>1 Domestic</td> <td>5 Public Water Supply</td> <td>9 Dewatering</td> </tr> <tr> <td>2 Irrigation</td> <td>6 Oil Field Water Supply</td> <td>10 Monitoring Well</td> </tr> <tr> <td>3 Feedlot</td> <td><u>7 Domestic (Lawn & Garden)</u></td> <td>11 Injection Well</td> </tr> <tr> <td>4 Industrial</td> <td>8 Air Conditioning</td> <td>12 Other _____</td> </tr>
Was a chemical / bacteriological sample submitted to Department? Yes _____ No _____ If yes, mo/day/yr sample was submitted _____ Water Well Disinfected: Yes <u>X</u> No _____																																			
5	TYPE OF BLANK CASING USED:																																		
<table style="width:100%; border: none;"> <tr> <td><u>1 Steel</u></td> <td>3 RMP (SR)</td> <td>5 Wrought</td> <td>7 Fiberglass</td> <td>9 Other (Specify below)</td> </tr> <tr> <td><u>2 PVC</u></td> <td>4 ABS</td> <td>6 Asbestos-Cement</td> <td>8 Concrete Tile</td> <td></td> </tr> </table>									<u>1 Steel</u>	3 RMP (SR)	5 Wrought	7 Fiberglass	9 Other (Specify below)	<u>2 PVC</u>	4 ABS	6 Asbestos-Cement	8 Concrete Tile																		
<u>1 Steel</u>	3 RMP (SR)	5 Wrought	7 Fiberglass	9 Other (Specify below)																															
<u>2 PVC</u>	4 ABS	6 Asbestos-Cement	8 Concrete Tile																																
Blank casing diameter <u>1 1/4</u> in. Was casing pulled? Yes <u>X</u> No _____ If yes, how much _____ Casing height above or below land surface <u>3 ft</u> in.																																			
6	GROUT PLUG MATERIAL: <u>1 Neat cement</u> <u>2 Cement grout</u> 3 Bentonite 4 Other _____																																		
Grout Plug Intervals: From <u>25</u> ft. to <u>1</u> ft., From _____ ft. to _____ ft., From _____ to _____ ft.																																			
What is the nearest source of possible contamination:																																			
<table style="width:100%; border: none;"> <tr> <td><u>1 Septic tank</u></td> <td>6 Seepage pit</td> <td>11 Fuel storage</td> <td>16 Other (specify below)</td> </tr> <tr> <td><u>2 Sewer lines</u></td> <td>7 Pit privy</td> <td>12 Fertilizer storage</td> <td></td> </tr> <tr> <td>3 Watertight sewer lines</td> <td>8 Sewage lagoon</td> <td>13 Insecticide storage</td> <td></td> </tr> <tr> <td>4 Lateral lines</td> <td>9 Feedyard</td> <td>14 Abandoned water well</td> <td></td> </tr> <tr> <td>5 Cess pool</td> <td>10 Livestock pens</td> <td>15 Oil well/Gas well</td> <td></td> </tr> </table>									<u>1 Septic tank</u>	6 Seepage pit	11 Fuel storage	16 Other (specify below)	<u>2 Sewer lines</u>	7 Pit privy	12 Fertilizer storage		3 Watertight sewer lines	8 Sewage lagoon	13 Insecticide storage		4 Lateral lines	9 Feedyard	14 Abandoned water well		5 Cess pool	10 Livestock pens	15 Oil well/Gas well								
<u>1 Septic tank</u>	6 Seepage pit	11 Fuel storage	16 Other (specify below)																																
<u>2 Sewer lines</u>	7 Pit privy	12 Fertilizer storage																																	
3 Watertight sewer lines	8 Sewage lagoon	13 Insecticide storage																																	
4 Lateral lines	9 Feedyard	14 Abandoned water well																																	
5 Cess pool	10 Livestock pens	15 Oil well/Gas well																																	
Direction from well? <u>South</u> How many feet? <u>65 ft</u>																																			
<table border="1" style="width:100%; border-collapse: collapse;"> <thead> <tr> <th style="width:10%;">FROM</th> <th style="width:10%;">TO</th> <th style="width:80%;">PLUGGING MATERIALS</th> </tr> </thead> <tbody> <tr> <td><u>25</u></td> <td><u>1</u></td> <td><u>concrete grout</u></td> </tr> <tr> <td><u>3</u></td> <td><u>0</u></td> <td><u>compacted soil</u></td> </tr> <tr><td> </td><td> </td><td> </td></tr> <tr><td> </td><td> </td><td> </td></tr> <tr><td> </td><td> </td><td> </td></tr> <tr><td> </td><td> </td><td> </td></tr> <tr><td> </td><td> </td><td> </td></tr> <tr><td> </td><td> </td><td> </td></tr> </tbody> </table>									FROM	TO	PLUGGING MATERIALS	<u>25</u>	<u>1</u>	<u>concrete grout</u>	<u>3</u>	<u>0</u>	<u>compacted soil</u>																		
FROM	TO	PLUGGING MATERIALS																																	
<u>25</u>	<u>1</u>	<u>concrete grout</u>																																	
<u>3</u>	<u>0</u>	<u>compacted soil</u>																																	
7	CONTRACTOR'S OF LANDOWNER'S CERTIFICATION: This water well was plugged under my jurisdiction and was completed on (mo/day/year) <u>5-13-85</u> and this record is true to the best of my knowledge and belief. Kansas Water Well Contractor's License No. <u>Wichita 1534</u> This Water Well Record was completed on (mo/day/year) _____ under the business name of _____ by (signature) <u>S B L...</u>																																		

INSTRUCTIONS: Use typewriter or ball point pen. Please press firmly and print clearly. Please fill in blanks, underline or circle the correct answers. Send top three copies to Kansas Department of Health and Environment, Bureau of Water, Geology Section, 1000 SW Jackson St., Ste. 420, Topeka, Kansas 66612-1367. Telephone: 785/296-5522. Send one to Water Well Owner and retain one for your records.