WATER WELL RECORD Form WWC-5 KSA 82a-1212 ID No. AS-16

1 LOCATION OF WATER WELL:	Fraction	Section Number	Township Number	Range Number
County: Sedgwick	SE ¼ SE ¼ SE ¼	17	T 26 S	R 1 E/W

Distance and direction from nearest town or city street address of well if located within city?
Hills 66, 5403 North Broadway, Wichita, Ks

2 WATER WELL OWNER: Lewis Williams
RR#, St. Address, Box # : 15490 13th St
City, State, ZIP Code : Perry Ks 66073

Board of Agriculture, Division of Water Resources
Application Number:

3 LOCATE WELL'S LOCATON WITH AN "X" IN SECTION BOX:

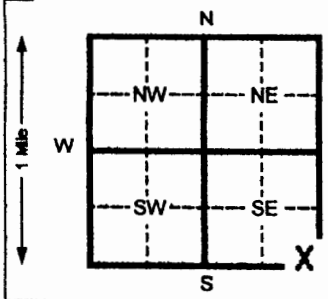

4 DEPTH OF COMPLETED WELL 30 ft. ELEVATION: 1332.22

Depth(s) Groundwater Encountered 1 ____ ft. 2 ____ ft. 3 ____ ft.

WELL'S STATIC WATER LEVEL ____ ft. below land surface measured on mo/day/yr ____

Pump test data: Well water was ____ ft. after ____ hours pumping ____ gpm

Est. Yield ____ gpm: Well water was ____ ft. after ____ hours pumping ____ gpm

Bore Hole Diameter 4.25 in. to 30 ft. and ____ in. to ____ ft.

WELL WATER TO BE USED AS: 1 Domestic 3 Feed lot 5 Public water supply 6 Oil field water supply 8 Air conditioning 9 Dewatering 11 Injection well 12 Other (Specify below)
2 Irrigation 4 Industrial 7 Lawn and garden (domestic) 10 Monitoring well

Was a chemical/bacteriological sample submitted to Department? Yes ____ No X ____ If yes, mo/day/yr sample was submitted ____ Water Well Disinfected? Yes ____ No X

5 TYPE OF BLANK CASING USED: 1 Steel 2 PVC 3 RMP (SR) 4 ABS 5 Wrought iron 6 Asbestos-Cement 7 Fiberglass 8 Concrete tile 9 Other (specify below)

CASING JOINTS: Glued ____ Clamped ____ Welded ____ Threaded X

Blank casing diameter 2 in. to 28 ft., Dia ____ in. to ____ ft., Dia ____ in. to ____ ft.

Casing height above land surface 0 in., weight .716 lbs./ft. Wall thickness or gauge No. .154

TYPE OF SCREEN OR PERFORATION MATERIAL: 1 Steel 2 Brass 3 Stainless steel 4 Galvanized steel 5 Fiberglass 6 Concrete tile 7 PVC 8 RMP (SR) 9 ABS 10 Asbestos-cement 11 Other (specify) ____ 12 None used (open hole)

SCREEN OR PERFORATION OPENINGS ARE: 1 Continuous slot 2 Louvered shutter 3 Mill slot 4 Key punched 5 Gauzed wrapped 6 Wire wrapped 7 Torch cut 8 Saw cut 9 Drilled holes 10 Other (specify) ____ 11 None (open hole)

SCREEN-PERFORATED INTERVALS: From 28 ft. to 30 ft. From ____ ft. to ____ ft.
From ____ ft. to ____ ft. From ____ ft. to ____ ft.

GRAVEL PACK INTERVALS: From 24 ft. to 30 ft. From ____ ft. to ____ ft.
From ____ ft. to ____ ft. From ____ ft. to ____ ft.

6 GROUT MATERIAL: 1 Neat cement 2 Cement grout 3 Bentonite 4 Other Bentonite pellets

Grout Intervals From 2 3 14 ft. From 14 ft. to 24 ft. From ____ ft. to ____ ft.

What is the nearest source of possible contamination:
1 Septic tank 2 Sewer lines 3 Watertight sewer lines 4 Lateral lines 5 Cess pool 6 Seepage pit 7 Pit privy 8 Sewage lagoon 9 Feedyard 10 Livestock pens 11 Fuel storage 12 Fertilizer storage 13 Insecticide storage 14 Abandoned water well 15 Oil well/ Gas well 16 Other (specify below) Contaminated site

Direction from well? How many feet?

FROM	TO	CODE	LITHOLOGIC LOG	FROM	TO	PLUGGING INTERVALS
0	3		Clay backfill			
3	14		Sand			
14	22		Very fine to fine grained sand			
22	28		Grades to mixed sand & gravel			
28	29.5		Weathered shale			
29.5	30		Gray shale			

7 CONTRACTOR'S OR LANDOWNER'S CERTIFICATION: This water well was (1) constructed, (2) reconstructed, or (3) plugged under my jurisdiction and was completed on (mo/day/yr) 4-11-05 and this record is true to the best of my knowledge and belief. Kansas Water Well Contractor's License No. 554 This Water Well Record was completed on (mo/day/yr) 9-9-05 under the business name of Woofter Pump & Well Inc. by (signature) Jay L Woofter

INSTRUCTIONS:. Please fill in blanks and circle the correct answers. Send three copies to Kansas Department of Health and Environment, Bureau of Water, 1000 S W Jackson St., Ste. 420, Topeka, Kansas 66612-1367. Telephone: 913-296-5545. Send one to WATER WELL OWNER and retain one for your records.

OFFICE USE ONLY T R SEC

Form provided by Forms-On-A-Disk, Inc. · Dallas, Texas · (214) 340-9429